

MISSISSIPPI DEPARTMENT OF NATURAL RESOURCES

Bureau of Land and Water Resources

Southport Mall

P.O. Box 10631

Jackson, Mississippi 39209

WATER WELL DRILLERS LOG

Jackson
P 2/19
6-7-85

L

6-7-85 19 Conrad Water Well Sew. firm name Jackson county well located

LANDOWNER: Genable B. Cooke
3305 Havell Road
Gautier, Miss.
(mailing address) 39553

description of formations encountered	from	to
<u>Top soil</u>	<u>0</u>	<u>10'</u>
<u>Blue Clay</u>	<u>10'</u>	<u>46'</u>
<u>White coarse sand</u>	<u>46'</u>	<u>87'</u>
<u>Blue Clay</u>	<u>87'</u>	<u>133'</u>
<u>Blue Clay & chunky sand</u>	<u>133'</u>	<u>205'</u>
<u>gray coarse sand</u>	<u>205'</u>	<u>300'</u>
<u>5' 2" Tail Pipe</u>		

WELL LOCATION:
sec 31 T 7 S R 6 W
1N miles (distance) of GAUTIER (nearest town)

WELL PURPOSE: Home
(home, irrigation, municipal, industrial)

- WELL COMPLETION DATA:
- diameter (inches) 2"
 - total depth (feet) 300'
 - static water level (feet) 54' ^{below} ~~above~~ top of ground.
 - casing PVC (material), 290' (depth)
2" (size) if telescope see back.
 - screen 10' (length), 290' (depth to top)
2" (size), PVC (material)
 - pump Elect. (HP), — (yield gpm)
(type power)
 - electric log no (yes or no)
— (organization running log)
 - how well bottom plugged fresh water


RECEIVED
JUL 7 1985

DRILLERS REMARKS: —

Department of Natural Resources
Bureau of Land and Water Resources

If well telescopes please sketch and show depths.

GROUND LEVEL

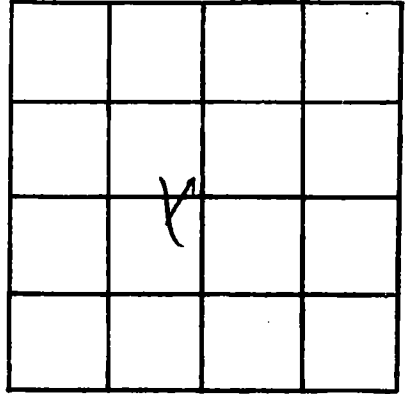

SECTION 31

Please indicate well location X.

ADDITIONAL INFORMATION

If more than one screen, show locations of each on sketch.