

MISSISSIPPI DEPARTMENT OF NATURAL RESOURCES

Bureau of Land and Water Resources

Southport Mall

P.O. Box 10631

Jackson, Mississippi 39209

WATER WELL DRILLERS LOG

JACKSON
P 2121

7-9-85
date well completed

Coast Water Well Sew.
firm name

Jackson
county well located


OWNER: M. W. Langley
P.O. Box 353
Gautier, Miss.
(mailing address) 39553

description of formations encountered	from	to
Top soil	0	2'
Pink coarse sand	2'	5'
Red. & Gray Clay	5'	14'
White coarse sand	14'	68'
Blue Clay	68'	115'
Gray fine sand	115'	142'
Blue Clay	142'	164'
Gray med. sand	164'	169'
Blue Clay	169'	182'
Gray fine sand	182'	230'
Blue Clay	230'	235'
Gray med. sand	235'	270'
Gray coarse sand	270'	288'
Blue Clay	288'	290'

WELL LOCATION:
sec. 31 T. 7 N. R. 6 E.
IN miles (distance) GAUTIER (direction) (nearest town)

WELL PURPOSE: Home
(home, irrigation, municipal, industrial)

- WELL COMPLETION DATA:
- diameter (inches) 2"
 - total depth (feet) 290'
 - static water level (feet) 19' below above top of ground.
 - casing PVC (material) 280' (depth)
2" (size) if telescope see back.
 - screen 10' (length) 280' (depth to top)
2" (size) PVC (material)
 - pump _____ (HP) _____ (yield gpm)
(type power) _____
 - electric log No (yes or no)
(organization running log)
 - how well bottom plugged Lock with valve

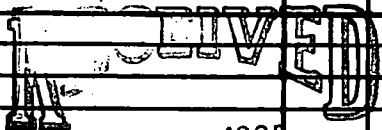


NOV - 5 1985

DRILLERS REMARKS: _____

Department of Natural Resources
Bureau of Land & Water Resources

If well telescopes please sketch and show depths.

GROUND LEVEL

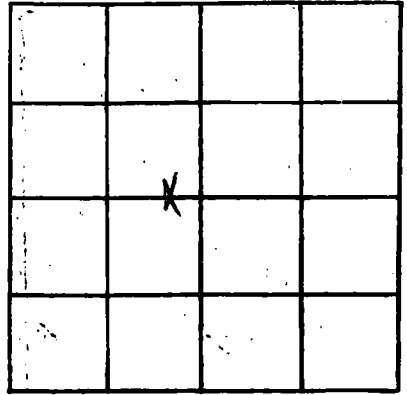

SECTION 31

Please indicate well location X.

ADDITIONAL INFORMATION

If more than one screen,
show locations of each on sketch.