

MISSISSIPPI DEPARTMENT OF NATURAL RESOURCES

Bureau of Land and Water Resources

Southport Mall

P.O. Box 10631

Jackson, Mississippi 39209

WATER WELL DRILLERS LOG

Jackson
P 2/25

2-14-86 date well completed 19 Coon Waterwell Jackson firm name county well located


LANDOWNER	Description of formations encountered	from	to
Dorothy Patten	Top Soil	0	1
Maurier, MS 39553 (mailing address)	Red Sand	1	5
WELL LOCATION: sec. 8 T. 7 R. 6 1/4 miles of MAURIER (distance) (direction) (nearest town)	Brown Clay	5	7
WELL PURPOSE: Home (home, irrigation, municipal, industrial)	White Coarse Sand	7	15
WELL COMPLETION DATA:	Blue Clay	15	44
(1) diameter (inches) 2"	White Coarse Sand	44	182
(2) total depth (feet) 295'	Blue Clay	182	195
(3) static water level (feet) 30' below top of ground	Blue Clay w/ Breaks Sand	195	220
(4) casing PVC, 280', CL (material) (depth)	White Coarse Sand	220	295
2" if telescope see back. (size)	well 290		Hole
(5) screen 10', 280' (length) (depth to top)			
2" PVC (size) (material)			
(6) pump 1/2 h.p., 9 1/2 (HP) (yield gpm)			
Electric (type power)			
(7) electric log NO (yes or no)			
(organization running log)			
(8) how well bottom plugged Backwash valve			
DRILLERS REMARKS: 5' 2" tail pipe			

RECEIVED
MAR 7 - 1986

Department of Natural Resources
Bureau of Land & Water

If well telescopes please sketch and show depths.

GROUND LEVEL

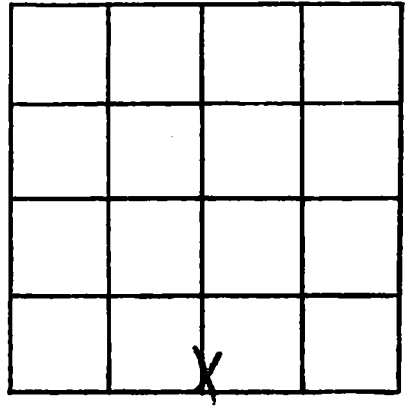

SECTION 8

Please indicate well location X.

ADDITIONAL INFORMATION

Lined area for additional information.

If more than one screen, show locations of each on sketch.