

MISSISSIPPI DEPARTMENT OF NATURAL RESOURCES

Bureau of Land and Water Resources

Southport Mall

P.O. Box 10631

Jackson, Mississippi 39209

WATER WELL DRILLERS LOG

JACKSON
P 2126

2/21/86 date well completed
19 Coast Water Well Svc. firm name
Jackson county well located

LANDOWNER: Burrice Howard
PO Box 1310
Escatawpa ms
(mailing address)

Description of formations encountered	from	to
Brown Clay	0	11
Blue Clay	11	45
White Coarse Sand + Gravel	45	105

WELL LOCATION:
sec. 2 T. 7 N. R. 6 E
1 miles N of Escatawpa
(distance) (direction) (nearest town)

WELL PURPOSE: IRIGATION
(home, irrigation, municipal, industrial)

- WELL COMPLETION DATA:
- (1) diameter (inches) 4"
 - (2) total depth (feet) 105'
 - (3) static water level (feet) 5 below above top of ground.
 - (4) casing Galv., 85'
(material), (depth)
4" if telescope see back.
(size)
 - (5) screen 20', 85'
(length), (depth to top)
4", Galv.
(size), (material)
 - (6) pump 2, 85
(HP), (yield gpm)
Elect
(type power)
 - (7) electric log no
(yes or no)
(organization running log)
 - (8) how well bottom plugged Backwash valve


DRILLERS REMARKS:

RECEIVED
MAR 7 - 1986

Department of Natural Resources
Bureau of Land & Water Resources

If well telescopes please sketch and show depths.

GROUND LEVEL

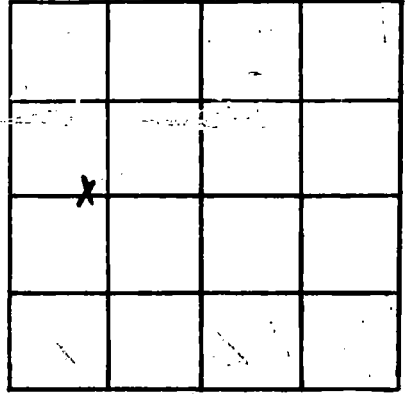

SECTION 2

Please indicate well location X.

ADDITIONAL INFORMATION

If more than one screen,
show locations of each on sketch.