

MISSISSIPPI DEPARTMENT OF NATURAL RESOURCES

Bureau of Land and Water Resources

Southport Mall

P.O. Box 10631

Jackson, Mississippi 39209

WATER WELL DRILLERS LOG

JACKSON
P 2/28

Oct. 4, 1985

date well completed

Coast Water Well

firm name

Jackson

county well located

LANDOWNER: Dr. Anderson

1400 20th Avenue

Meridian Mo. 39301

(mailing address)

WELL LOCATION:

sec. 8 T. 7 R. 6
N miles of GAULTIER
(distance) (direction) (nearest town)

WELL PURPOSE: home
(home, irrigation, municipal, industrial)

WELL COMPLETION DATA:

- (1) diameter (inches) 2"
- (2) total depth (feet) 290'
- (3) static water level (feet) 53 ^{below} _{above} top of ground
- (4) casing PVC 275' _{cc}
(material) (depth)
2" (size) If telescope see back.
- (5) screen 10' 275'
(length) (depth to top)
2' PVC (material)
- (6) pump 1/2 H.P. 9 1/2
(HP) (yield gpm)
Elex. (type power)
- (7) electric log no
(yes or no)
(organization running log)
- (8) how well bottom plugged
Backwash valve

description of formations encountered

from to

Top Soil	0'	3'
Red Coarse Sand	3'	8'
Brown Clay	8'	15'
Blue Clay	15'	60'
White Coarse Sand	60'	115'
Blue Clay	115'	160'
Blue Fine Sand	160'	165'
Blue Clay	165'	205'
Gray Coarse Sand	205'	240'
Rock (concrete)	240'	241'
Gray Coarse Sand	241'	290'

well 285

DRILLERS REMARKS:


5' tail pipe

RECEIVED

NOV 26 1985

If well telescopes please sketch and show depths.

GROUND LEVEL

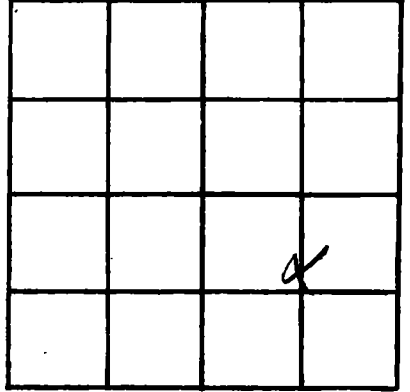

SECTION 8

Please indicate well location X.

ADDITIONAL INFORMATION

If more than one screen, show locations of each on sketch.