

MISSISSIPPI DEPARTMENT OF NATURAL RESOURCES

Bureau of Land and Water Resources

Southport Mall

P.O. Box 10631

Jackson, Mississippi 39209

WATER WELL DRILLERS LOG

JACKSON  
P2130

2/24/86 19 Coast Water Well Svc Jackson  
date well completed firm name county well located

LANDOWNER: Bunnie Howard  
PO Box 1310  
Escatawpa Ms  
(mailing address)

Description of formations encountered	from	to
Brown Clay	0	11'
Blue Clay	11	50
White Coarse Sand + Gravel	50	105
		feet

WELL LOCATION:  
sec. 2 T. 7 S. R. 6 W.  
1 miles N of ESCATAWPA  
(distance) (direction) (nearest town)

WELL PURPOSE:  
(home, irrigation, municipal, industrial)


WELL COMPLETION DATA:  
(1) diameter (inches) 4"  
(2) total depth (feet) 105'  
(3) static water level (feet) 7 below above top of ground.  
(4) casing Galv. 85' cc  
(material) (depth)  
4" if telescope see back.  
(size)  
(5) screen 20' 85'  
(length) (depth to top)  
4" Galv.  
(size) (material)  
(6) pump 2 85  
(HP) (yield gpm)  
Elect  
(type power)  
(7) electric log no  
(yes or no)  
(organization running log)  
(8) how well bottom plugged  
Backwash valve

DRILLERS REMARKS:

RECEIVED  
MAR 7 - 1986  
Department of Natural Resources  
Bureau of Land & Water Resources

If well telescopes please sketch and show depths.

GROUND LEVEL

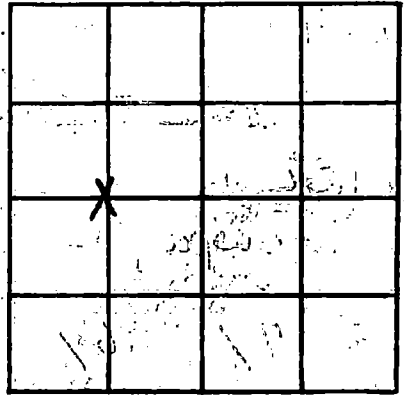

SECTION 2

Please indicate well location X.

ADDITIONAL INFORMATION

A series of horizontal lines for writing additional information.

If more than one screen, show locations of each on sketch.