

MISSISSIPPI DEPARTMENT OF NATURAL RESOURCES

Bureau of Land and Water Resources

Southport Mall

P.O. Box 10631

Jackson, Mississippi 39209

WATER WELL DRILLERS LOG

Jackson  
P 2131

4-23-86

19 COAST WATERWELL SVC Jackson

date well completed

firm name

county well located

LANDOWNER: PAT ZACHARY

Oak St,

Gautier Ms, 39553

(mailing address)

WELL LOCATION:

sec 8 T 7 N R 6 W  
IN miles (distance) (direction) of GAUTIER (nearest town)

WELL PURPOSE: home  
(home, irrigation, municipal, industrial)

WELL COMPLETION DATA:

- (1) diameter (inches) 2"
- (2) total depth (feet) 280'
- (3) static water level (feet) 17' below top of ground.
- (4) casing PVC, 265' (material) (depth)
- 2" (size) If telescope see back.
- (5) screen 10' (length), 265' (depth to top)
- 2" (size), PVC (material)
- (6) pump (HP) (yield gpm)
- (type power)
- (7) electric log no (yes or no)
- (organization running log)

(8) how well bottom plugged BACKWASH WAVE

DRILLERS REMARKS:

5'-2" PVC TAILPIPE

description of formations encountered

from

to


TOP SOIL	0	1
BROWN CLAY	1	14
BLUE CLAY	14	75
WHITE COARSE SAND	75	112
BLUE CLAY	112	114
WHITE COARSE SAND	114	118
BLUE CLAY	118	192
GRAY MED SAND	192	209
BLUE CLAY	209	220
WHITE COARSE SAND	220	275
BLUE CLAY	275	280
	275	

RECEIVED  
MAY 12 1986

Department of Natural Resources  
Bureau of Land & Water

If well telescopes please sketch and show depths.

GROUND LEVEL

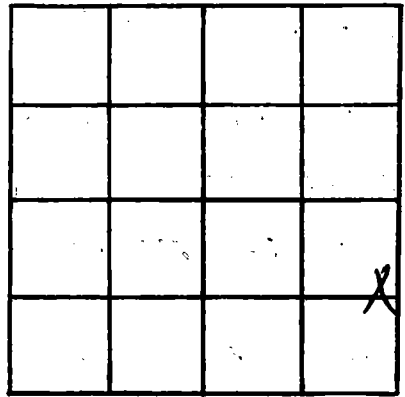

SECTION 8

Please indicate well location X.

ADDITIONAL INFORMATION

If more than one screen,  
show locations of each on sketch.