

MISSISSIPPI DEPARTMENT OF NATURAL RESOURCES

Bureau of Land and Water Resources

Southport Mall

P.O. Box 10631

Jackson, Mississippi 39209

WATER WELL DRILLERS LOG

Jackson
P 9/33

date well completed 19 3/23 firm name Loanter well Co county well located Jackson

LANDOWNER: J. D. Small

description of formations encountered

from

to

23 N Tyler Ave
Passadena
(mailing address)

hard shell 5 80
limestone 80 95

WELL LOCATION:

sec. 10 T. 8 N. R. 6 E
City of Passadena
(distance) (direction) (nearest town)

WELL PURPOSE: irrigation
(home, irrigation, municipal, industrial)

WELL COMPLETION DATA:

- (1) diameter (inches) 2"
- (2) total depth (feet) 95'
- (3) static water level (feet) 16 ^{below} above top of ground.
- (4) casing ALC 90'
(material) (depth)
(size) If telescope see back.
- (5) screen 5' 90'
(length) (depth to top)
2" ALC
(size) (material)
- (6) pump 1/2 6
(HP) (yield gpm)
AL
(type power)
- (7) electric log NO
(yes or no)
N/A
(organization running log)
- (8) how well bottom plugged _____


RECEIVED
APR 25 1986

Department of Natural Resources
Bureau of Land & Water Resources

DRILLERS REMARKS:

If well telescopes please sketch and show depths.

GROUND LEVEL

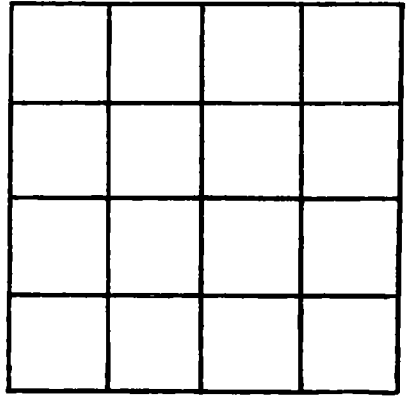

SECTION _____

Please indicate well location X.

ADDITIONAL INFORMATION

If more than one screen, show locations of each on sketch.