

MISSISSIPPI DEPARTMENT OF NATURAL RESOURCES

Bureau of Land and Water Resources

Southport Mall

P.O. Box 10631

Jackson, Mississippi 39209

WATER WELL DRILLERS LOG

JACKSON
P 2136

5-20-86 19
date well completed

Coast Water Well
firm name

Jackson
county well located

LANDOWNER: Jim Meagher

description of formations encountered

from

to

1113 Hickory Hill Dr.

Gautier, MS 39553

(mailing address)

Top Soil

0

1

Red Clay

1

54

Red Fine sand

54

60

Red Clay

60

70

Red Coarse sand

70

100

WELL LOCATION:

sec. 7 T. 7 R. 6
4 miles NORTH of GAUTIER
(distance) (direction) (nearest town)

WELL PURPOSE:

home

(home, irrigation, municipal, industrial)

WELL COMPLETION DATA:

(1) diameter (inches) 4"
(2) total depth (feet) 100'
(3) static water level (feet) 32 below above top of ground.

(4) casing PRC, 80'
(material) (depth)
4"
(size) if telescope see back.

(5) screen 20', 80'
(length) (depth to top)
4"
(size) PRC
(material)

(6) pump 1hp 25
(HP) (yield gpm)
sub
elect.
(type power)

(7) electric log no
(yes or no)

(organization running log)

(8) well bottom plugged
Backwash valve


DRILLERS REMARKS:

RECEIVED
JUL 18 1986

Department of Natural Resources
Bureau of Land & Water Resources

If well telescopes please sketch and show depths.

GROUND LEVEL

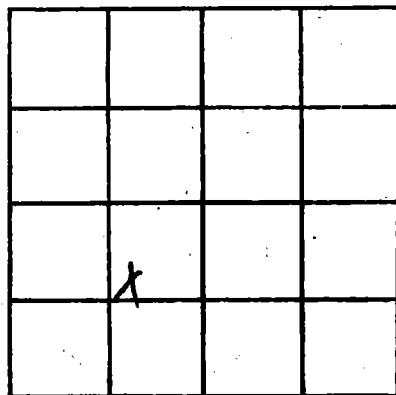

SECTION 7

Please indicate well location X.

ADDITIONAL INFORMATION

If more than one screen, show locations of each on sketch.