

MISSISSIPPI DEPARTMENT OF NATURAL RESOURCES

Bureau of Land and Water Resources

Southport Mall

P.O. Box 10631

Jackson, Mississippi 39209

WATER WELL DRILLERS LOG

Jackson  
P2138

6-4-86 19 Coastwater well Jackson  
date well completed firm name county well located

LANDOWNER:	description of formations encountered	from	to
<u>W. Gautier</u>			
<u>2810 Washington</u>	<u>Top soil</u>	<u>0</u>	<u>1</u>
<u>Pascagoula</u>	<u>White Coarse Sand</u>	<u>1</u>	<u>14</u>
(mailing address) <u>39367</u>	<u>Blue clay w/ streaks of sand</u>	<u>14</u>	<u>98</u>
<b>WELL LOCATION:</b>	<u>White Coarse Sand</u>	<u>98</u>	<u>115</u>
sec. <u>8</u> T. <u>8</u> S. R. <u>6</u> E	<u>Pea Gravel</u>	<u>115</u>	<u>120</u>
<u>1N</u> miles (distance) <u>SW</u> (direction) of <u>Pascagoula</u> (nearest town)			
<b>WELL PURPOSE:</b> <u>Irrigation</u> (home, irrigation, municipal, industrial)			
<b>WELL COMPLETION DATA:</b>			
(1) diameter (inches) <u>2"</u>			
(2) total depth (feet) <u>120'</u>			
(3) static water level (feet) <u>22</u> <u>below</u> above top of ground.			
(4) casing <u>PVC</u> <u>105'</u> (material) (depth)			
<u>2"</u> (size) If telescope see back.	<u>105</u>		
(5) screen <u>10'</u> <u>105'</u> (length) (depth to top)	<u>10</u>		
<u>2"</u> (size) <u>PVC</u> (material)	<u>well 115</u>		
(6) pump _____ (HP) _____ (yield gpm)			
(type power) _____			
(7) electric log <u>no</u> (yes or no)			
(organization running log) _____			
(8) how well bottom plugged <u>backwash valve</u>			
<b>DRILLERS REMARKS:</b>			
<u>5' - 2" PVC tail pipe</u>			


**RECEIVED**

AUG 20 1986

Department of Natural Resources  
Bureau of Land & Water Resources

If well telescopes please sketch and show depths.

GROUND LEVEL

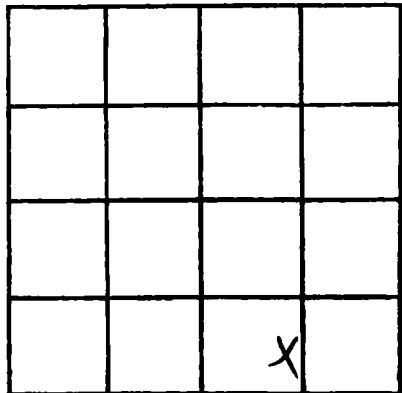

SECTION 8

Please indicate well location X.

ADDITIONAL INFORMATION

A series of horizontal lines for writing additional information.

If more than one screen, show locations of each on sketch.