

# MISSISSIPPI DEPARTMENT OF NATURAL RESOURCES

Bureau of Land and Water Resources

P.O. Box 10631

Jackson, Mississippi 39209

## WATER WELL DRILLERS LOG

COUNTY WELL LOCATED <b>Jackson</b>	
WELL NUMBER <b>P2147</b>	CODED
DATE WELL COMPLETED <b>3-24-87</b>	

PERMIT NUMBER
NAME OF DRILLING FIRM <b>Coast Water Well Svc. Inc.</b>

NAME & MAILING ADDRESS OF LANDOWNER <b>Burnice Harvard</b>			
<b>Po Box 1310</b>			
<b>Escatawpa ms</b>			
WELL LOCATION:	SEC	TOWNSHIP	RANGE
	<b>2</b>	<b>7<sup>N</sup></b>	<b>6<sup>E</sup></b>
DISTANCE	DIRECTION	NEAREST TOWN	
<b>—</b>	<b>—</b>	<b>Escatawpa</b>	
OTHER LANDMARK			
WELL PURPOSE: Home, Irrigation, Municipal, Industrial, Fish Pond, etc. <b>fish pond</b>			

PUMP DATA		
PUMP TYPE (Circle One): <input checked="" type="radio"/> Submersible, Turbine, Jet, Flowing Well, Other (Describe) _____		
POWER TYPE (Circle One): <input checked="" type="radio"/> Electric, Tractor, Diesel, Gasoline, Butane, Other (Describe) _____		
Pump Capacity (GPM) <b>114</b>	No. of Stages <b>4</b>	Setting Depth <b>63</b> FT.
PUMP TEST		
Well yielded _____ GPM with a drawdown of _____ ft. after _____ hours of pumping		


WELL DATA		
Well Depth <b>90'</b>	Casing Diameter (In.) <b>4"</b>	Casing Length (Ft.) <b>70'</b>
Type of Casing <b>PVC</b>	Hole Depth <b>90'</b>	Depth to Static Water Level <b>14'</b>
TYPE OF COMPLETION: (Circle One or More): <input checked="" type="radio"/> Gravel Packed, <input type="radio"/> Underreamed, <input type="radio"/> Telescoped, <input type="radio"/> Natural Development, <input type="radio"/> Open Hole, <input type="radio"/> Other (Describe) _____		
Top of Lap Pipe or Reduction in Casing		
FEET		IF TELESCOPED OR MORE THAN ONE SCREEN: USE BACK PAGE

LOG DATA	
TYPE OF LOG RUN (Circle One): <input checked="" type="radio"/> No Log Run, <input type="radio"/> Electric, <input type="radio"/> Gamma Ray, <input type="radio"/> Density, <input type="radio"/> Sonic, <input type="radio"/> Neutron, Other (Describe) _____	
Name of Organization Running Log	

SCREEN DATA		
Diameter - Inches <b>4"</b>	Length - Feet <b>20'</b>	Slot Size - Inches <b>.010</b>
Screen Type <b>PVC</b>	Depth to Bottom - Feet <b>90'</b>	


GEOLOGIC DATA (Office Use Only)			
Surface Elev.	Geologic Unit	Unit Thickness	Depth to Top
Subs. SWL	Date	Analysis	Aquifer Test
Driller's Remarks			

DESCRIPTION OF FORMATIONS ENCOUNTERED	FROM	TO
<b>Brown Clay</b>	<b>0</b>	<b>5</b>
<b>White Coarse sand</b>	<b>5</b>	<b>10</b>
<b>Blue Clay</b>	<b>10</b>	<b>60</b>
<b>White Coarse sand + pea gravel</b>	<b>60</b>	<b>90</b>

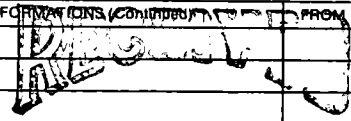FORMATIONS (continued)		FROM	TO
			
MAY 21 1987			
Department of Natural Resources Bureau of Land & Water Resources			
IF MORE SPACE IS NEEDED, USE BACK			

If well telescopes please sketch and show depths.

GROUND LEVEL

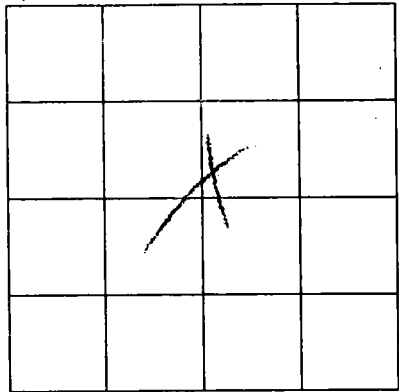

SECTION 2

Please indicate well location X.

ADDITIONAL INFORMATION

If more than one screen,  
show location of each on sketch.