

# MISSISSIPPI DEPARTMENT OF NATURAL RESOURCES

Bureau of Land and Water Resources

P.O. Box 10631

Jackson, Mississippi 39209

## WATER WELL DRILLERS LOG

COUNTY WELL LOCATED <b>Jackson</b>	
WELL NUMBER <b>P 2148</b>	CODED
DATE WELL COMPLETED <b>3-27-87</b>	

PERMIT NUMBER
NAME OF DRILLING FIRM <b>Coast Water Well Svc. Inc.</b>

NAME & MAILING ADDRESS OF LANDOWNER <b>Burnice Howard</b> <b>PO Box 1310</b> <b>Escatawpa mo</b>			
WELL LOCATION:	SEC	TOWNSHIP	RANGE
	<b>2</b>	<b>7 N</b>	<b>6 E</b>
DISTANCE	DIRECTION	NEAREST TOWN	
<b>-</b>	<b>-</b>	<b>Escatawpa</b>	
OTHER LANDMARK			
WELL PURPOSE: Home, Irrigation, Municipal, Industrial, Fish Pond, etc. <b>fish pond</b>			

<b>PUMP DATA</b>		
PUMP TYPE (Circle One): Submersible, Turbine, <b>Flowing Well</b> , Other (Describe)		
POWER TYPE (Circle One): <b>Electric</b> , Tractor, Diesel, Gasoline, Butane, Other (Describe)		
Pump Capacity (GPM) <b>185'</b>	No. of Stages <b>4'</b>	Setting Depth <b>83</b> FT.
PUMP TEST		
Well yielded _____ GPM with a drawdown of _____ ft. after _____ hours of pumping		

<b>WELL DATA</b>		
Well Depth <b>110'</b>	Casing Diameter (In.) <b>4"</b>	Casing Length (Ft.) <b>90'</b>
Type of Casing <b>PVC</b>	Hole Depth <b>110'</b>	Depth to Static Water Level <b>16ft.</b>
TYPE OF COMPLETION: (Circle One or More): Gravel Packed, Underreamed, Telescoped, Natural Development, Open Hole, Other <b>Natural Development</b>		
Top of Lap Pipe or Reduction in Casing		
FEET <input type="checkbox"/> IF TELESCOPED OR MORE THAN ONE SCREEN: USE BACK PAGE		

<b>LOG DATA</b>	
TYPE OF LOG RUN (Circle One): Electric, Gamma Ray, Density, Sonic, <b>No Log Run</b> , Neutron, Other (Describe)	
Name of Organization Running Log	

<b>SCREEN DATA</b>		
Diameter - Inches <b>4"</b>	Length - Feet <b>20'</b>	Slot Size - Inches <b>.000</b>
Screen Type <b>PVC</b>		Depth to Bottom - Feet <b>110'</b>

<b>GEOLOGIC DATA (Office Use Only)</b>			
Surface Elev.	Geologic Unit	Unit Thickness	Depth to Top
Subs. SWL	Date	Analysis	Aquifer Test

Driller's Remarks


DESCRIPTION OF FORMATIONS ENCOUNTERED	FROM	TO
<b>Brown Clay</b>	<b>0</b>	<b>5</b>
<b>White Coarse Sand</b>	<b>5</b>	<b>13</b>
<b>Blue Clay</b>	<b>13</b>	<b>88</b>
<b>White Coarse Sand + Red Gravel</b>	<b>88</b>	<b>110</b>

FORMATIONS (Continued)	FROM	TO
<b>PROTECTED</b>		
<b>MAY 21 1987</b>		
<b>Department of Natural Resources</b> <b>Bureau of Land &amp; Water Resources</b>		

IF MORE SPACE IS NEEDED, USE BACK

If well telescopes please sketch and show depths.

GROUND LEVEL

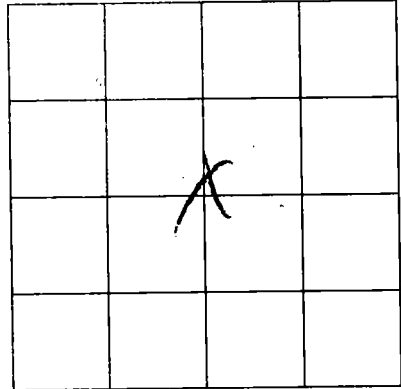

SECTION 2

Please indicate well location X.

ADDITIONAL INFORMATION

If more than one screen,  
show location of each on sketch.