

MISSISSIPPI DEPARTMENT OF NATURAL RESOURCES
Bureau of Land and Water Resources

P.O. Box 10631
Jackson, Mississippi 39209
WATER WELL DRILLERS LOG

COUNTY WELL LOCATED Jackson	
WELL NUMBER P2149	CODED
DATE WELL COMPLETED 3-28-87	

PERMIT NUMBER
NAME OF DRILLING FIRM Coast Water Well Svc., Inc.

NAME & MAILING ADDRESS OF LANDOWNER Burnice Havard			
PO Box 1310			
Escatawpa mo			
WELL LOCATION:	SEC	TOWNSHIP	RANGE
	2	7^N	6^E
DISTANCE	DIRECTION	NEAREST TOWN	
—	—	Escatawpa	
OTHER LANDMARK			
WELL PURPOSE: Home, Irrigation, Municipal, Industrial, Fish Pond, etc. fish pond			

PUMP DATA			
PUMP TYPE (Circle One): <input checked="" type="radio"/> Submersible , Turbine, Jet, Flowing Well, Other (Describe)			
POWER TYPE (Circle One): <input checked="" type="radio"/> Electric , Tractor, Diesel, Gasoline, Butane, Other (Describe)			
Pump Capacity (GPM)	No. of Stages	Setting Depth	
114	4	63 FT.	
PUMP TEST			
Well yielded — GPM with a drawdown of — ft. after — hours of pumping			

WELL DATA		
Well Depth 110'	Casing Diameter (in.) 4"	Casing Length (Ft.) 90'
Type of Casing PVC	Hole Depth 110'	Depth to Static Water Level 18'
TYPE OF COMPLETION: (Circle One or More): <input checked="" type="checkbox"/> Gravel Packed, <input type="checkbox"/> Underreamed, <input type="checkbox"/> Telescoped, <input checked="" type="checkbox"/> Natural Development, <input type="checkbox"/> Open Hole, <input type="checkbox"/> Other (Describe)		
Top of Lap Pipe or Reduction in Casing		
FEET <input type="checkbox"/> IF TELESCOPED OR MORE THAN ONE SCREEN: USE BACK PAGE		

LOG DATA			
TYPE OF LOG RUN (Circle One): Electric, Gamma Ray, Density, Sonic, <input checked="" type="radio"/> No Log Run , <input type="radio"/> Neutron, Other (Describe)			
Name of Organization Running Log			

SCREEN DATA		
Diameter - Inches 4"	Length - Feet 20'	Slot Size - Inches .010
Screen Type PVC		Depth to Bottom - Feet 110'


GEOLOGIC DATA (Office Use Only)			
Surface Elev.	Geologic Unit	Unit Thickness	Depth to Top
Subs. SWL	Date	Analysis	Aquifer Test

Driller's Remarks

DESCRIPTION OF FORMATIONS ENCOUNTERED	FROM	TO	FORMATIONS (Continued)	FROM	TO
Brown Clay	0	5	PROBABLE MAY 21 1987		
White Coarse Sand	5	13			
Blue Clay	13	88			
White Coarse Sand + Pea Gravel	88	110			
Department of Natural Resources Bureau of Land & Water Resources					
IF MORE SPACE IS NEEDED, USE BACK					

If well telescopes please sketch and show depths.

GROUND LEVEL

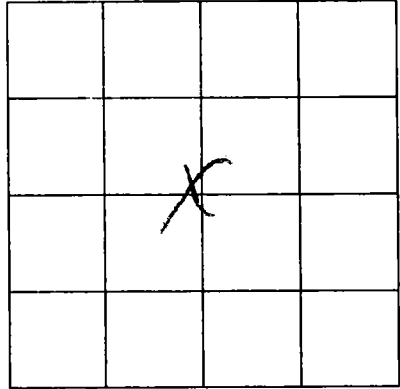

SECTION 2

Please indicate well location X.

ADDITIONAL INFORMATION

If more than one screen,
show location of each on sketch.