

**MISSISSIPPI DEPARTMENT OF NATURAL RESOURCES**  
Bureau of Land and Water Resources

P.O. Box 10631  
Jackson, Mississippi 39209  
**WATER WELL DRILLERS LOG**

COUNTY WELL LOCATED <b>Jackson</b>	
WELL NUMBER <b>2151</b>	CODED
DATE WELL COMPLETED <b>3-12-87</b>	

PERMIT NUMBER
NAME OF DRILLING FIRM <b>Coast Water Well Serv.</b>

NAME & MAILING ADDRESS OF LANDOWNER <b>Marvin Stockman</b>		
<b>1019 Bechtel Ave</b>		
<b>Pascagoula, Miss</b>		
WELL LOCATION: SEC	TOWNSHIP	RANGE
<b>1</b>	<b>8</b>	<b>6</b>
DISTANCE	DIRECTION	NEAREST TOWN
<b>1/2</b> Miles	<b>N</b>	<b>PASCAGOULA</b>
OTHER LANDMARK		
WELL PURPOSE: Home, Irrigation, Municipal, Industrial, Fish Pond, etc. <b>Domestic Down</b>		

<b>PUMP DATA</b>		
PUMP TYPE (Circle One): Submersible, Turbine, <b>(let)</b> Flowing Well, Other (Describe)		
POWER TYPE (Circle One): <b>(let)</b> Electric, Tractor, Diesel, Gasoline, Butane, Other (Describe)		
Pump Capacity (GPM) <b>14</b>	No. of Stages <b>2</b>	Setting Depth <b>FT.</b>
PUMP TEST		
Well yielded _____ GPM with a drawdown of _____ ft. after _____ hours of pumping		

<b>WELL DATA</b>		
Well Depth <b>90'</b>	Casing Diameter (In.) <b>2"</b>	Casing Length (Ft.) <b>80'</b>
Type of Casing <b>PVC</b>	Hole Depth <b>90'</b>	Depth to Static Water Level <b>15ft</b>
TYPE OF COMPLETION: (Circle One or More): <b>(let)</b> Gravel Packed, Underreamed, Telescoped, Natural Development, Open Hole, Other		
Top of Lap Pipe or Reduction in Casing <b>FEET</b> IF TELESCOPED OR MORE THAN ONE SCREEN: USE BACK PAGE		

<b>LOG DATA</b>	
TYPE OF LOG RUN (Circle One): Electric, Gamma Ray, Density, Sonic, <b>(let)</b> Neutron, Other (Describe)	
Name of Organization Running Log	

<b>SCREEN DATA</b>		
Diameter - Inches <b>2"</b>	Length - Feet <b>10'</b>	Slot Size - Inches <b>.008</b>
Screen Type <b>PVC</b>	Depth to Bottom - Feet <b>90'</b>	

<b>GEOLOGIC DATA (Office Use Only)</b>			
Surface Elev.	Geologic Unit	Unit Thickness	Depth to Top
Subs. SWL	Date	Analysis	Aquifer Test


Driller's Remarks

DESCRIPTION OF FORMATIONS ENCOUNTERED	FROM	TO
Top Soil	0	2
Red Coarse Sand	2	11
Blue Clay	11	35
White Coarse Sand	35	45
Blue Clay	45	50
White Coarse Sand	50	90

<b>RECEIVED</b>	
SEP 21 1987	
Department of Natural Resources Bureau of Land & Water Resources	
IF MORE SPACE IS NEEDED, USE BACK	

If well telescopes please sketch and show depths.

GROUND LEVEL

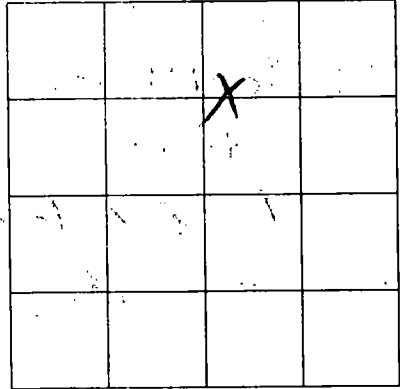

SECTION 1

Please indicate well location X.

ADDITIONAL INFORMATION

Lined area for additional information.

STANDARD  
CIVIL ENGINEERING

If more than one screen, show location of each on sketch.