

MISSISSIPPI DEPARTMENT OF NATURAL RESOURCES
Bureau of Land and Water Resources

P.O. Box 10631
Jackson, Mississippi 39209
WATER WELL DRILLERS LOG

COUNTY WELL LOCATED
Jackson

WELL NUMBER
P 2153

CODED

PERMIT NUMBER

DATE WELL COMPLETED
4-15-88

NAME OF DRILLING FIRM
COAST WATER

WELL SERVICE

NAME & MAILING ADDRESS OF LANDOWNER
Stanley Warner
805 POWELLS PT RD
GAUTIER MS

WELL LOCATION: SEC TOWNSHIP RANGE
16 7 N 16 W

DISTANCE DIRECTION NEAREST TOWN
5 Miles *N* of *GAUTIER*

OTHER LANDMARK
Lawn

WELL PURPOSE: Home, Irrigation, Municipal, Industrial, Fish Pond, etc.
Lawn

PUMP DATA

PUMP TYPE (Circle One):
Submersible, Turbine, **Jet** Flowing Well,
Other (Describe) _____

POWER TYPE (Circle One):
Electric, Tractor, Diesel, Gasoline, Butane,
Other (Describe) _____

Pump Capacity (GPM) No. of Stages Setting Depth
15 *2* *-* FT.

PUMP TEST
Well yielded _____ GPM with
a drawdown of _____ ft.
after _____ hours of pumping

WELL DATA

Well Depth <i>65'</i>	Casing Diameter (In.) <i>2"</i>	Casing Length (Ft.) <i>50'</i>
Type of Casing <i>PVC</i>	Hole Depth <i>65'</i>	Depth to Static Water Level <i>13'</i>

TYPE OF COMPLETION: (Circle One or More):
Gravel Packed, Underreamed, Telescoped,
Natural Development, Open Hole, Other

Top of Lap Pipe or Reduction in Casing
FEET IF TELESKOPED OR MORE THAN ONE SCREEN: USE BACK PAGE

LOG DATA

TYPE OF LOG RUN (Circle One):
Electric, Gamma Ray, Density, Sonic, **No Log Run**, Neutron,
Other (Describe) _____

Name of Organization Running Log

SCREEN DATA

Diameter - Inches <i>2"</i>	Length - Feet <i>15'</i>	Slot Size - Inches <i>.008</i>
Screen Type <i>PVC</i>	Depth to Bottom - Feet <i>65'</i>	

GEOLOGIC DATA (Office Use Only)

Surface Elev.	Geologic Unit	Unit Thickness	Depth to Top
Subs. SWL	Date	Analysis	Aquifer Test

Driller's Remarks

DESCRIPTION OF FORMATIONS ENCOUNTERED	FROM	TO
<i>Red Coarse Sand</i>	<i>0</i>	<i>25'</i>
<i>Blue Clay</i>	<i>25'</i>	<i>50'</i>
<i>Brown Mt. Sand</i>	<i>50'</i>	<i>65'</i>

RECEIVED

MAY 24 1988


Department of Natural Resources
Bureau of Land & Water Resources

FORMATIONS (Continued) FROM TO

IF MORE SPACE IS NEEDED, USE BACK

If well telescopes please sketch and show depths.

GROUND LEVEL

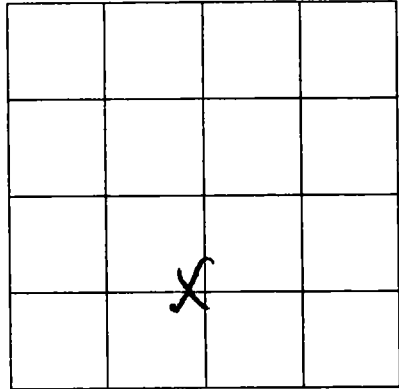

SECTION 6

Please indicate well location X.

ADDITIONAL INFORMATION

If more than one screen,
show location of each on sketch.