

MISSISSIPPI DEPARTMENT OF NATURAL RESOURCES
Bureau of Land and Water Resources

P.O. Box 10631
Jackson, Mississippi 39209
WATER WELL DRILLERS LOG

COUNTY WELL LOCATED JACKSON	
WELL NUMBER P 2154	CODED
DATE WELL COMPLETED 4-11-88	

PERMIT NUMBER
NAME OF DRILLING FIRM COAST WATER
WELL SERVICE

NAME & MAILING ADDRESS OF LANDOWNER ST Har Key			
POWELLS PT RD			
GAUTIER MS			
WELL LOCATION:	SEC	TOWNSHIP	RANGE
	6	7	6
DISTANCE	DIRECTION	NEAREST TOWN	
5 Miles	N	of GAUTIER	
OTHER LANDMARK			
WELL PURPOSE: Home, Irrigation, Municipal, Industrial, Fish Pond, etc. LAWN			

PUMP DATA		
PUMP TYPE (Circle One): Submersible, Turbine, Jet, Flowing Well, Other (Describe) _____		
POWER TYPE (Circle One): Electric, Tractor, Diesel, Gasoline, Butane, Other (Describe) _____		
Pump Capacity (GPM)	No. of Stages	Setting Depth FT.
PUMP TEST		
Well yielded _____ GPM with a drawdown of _____ ft. after _____ hours of pumping		

WELL DATA		
Well Depth 84' 7 8	Casing Diameter (In.) 2"	Casing Length (Ft.) 68'
Type of Casing PVC	Hole Depth 84'	Depth to Static Water Level 19'
TYPE OF COMPLETION: (Circle One or More): Gravel Packed, Underreamed, Telescoped, Natural Development, Open Hole, Other		
Top of Lap Pipe or Reduction in Casing FEET IF TELESCOPED OR MORE THAN ONE SCREEN: USE BACK PAGE		

LOG DATA	
TYPE OF LOG RUN (Circle One): Electric, Gamma Ray, Density, Sonic, Neutron, Other (Describe) _____	
Name of Organization Running Log	

SCREEN DATA		
Diameter - Inches 2"	Length - Feet 10'	Slot Size - Inches 008
Screen Type PVC	Depth to Bottom - Feet 78'	

GEOLOGIC DATA (Office Use Only)			
Surface Elev.	Geologic Unit	Unit Thickness	Depth to Top
Subs. SWL	Date	Analysis	Aquifer Test

Driller's Remarks

RECEIVED


DESCRIPTION OF FORMATIONS ENCOUNTERED	FROM	TO
RED CLAY	0	8
RED CLAY SAND	8	18
BLUE CLAY	18	45
BROWN RED SAND	45	84

FORMATIONS (Continued)	FROM	TO
MAY 24 1988		
Department of Natural Resources Bureau of Land & Water Resources		

IF MORE SPACE IS NEEDED, USE BACK

If well telescopes please sketch and show depths.

GROUND LEVEL

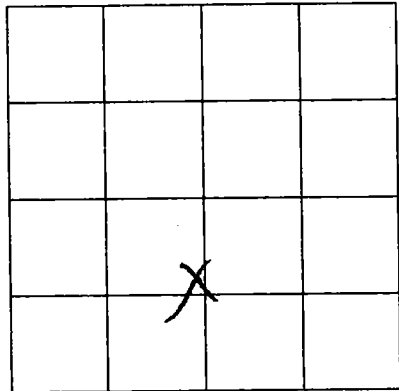

SECTION 6

Please indicate well location X.

ADDITIONAL INFORMATION

If more than one screen,
show location of each on sketch.