

MISSISSIPPI DEPARTMENT OF NATURAL RESOURCES

Bureau of Land and Water Resources

COUNTY WELL LOCATED
Jackson

WELL NUMBER **2162** CODED

DATE WELL COMPLETED
7-19-88

PERMIT NUMBER

NAME OF DRILLING FIRM
Coastwater Well Service

P.O. Box 10631
Jackson, Mississippi 39209
WATER WELL DRILLERS LOG

NAME & MAILING ADDRESS OF LANDOWNER
**Frank Lynn
3330 Catherine St.
Moss Point MS**

WELL LOCATION: SEC **10** TOWNSHIP **7^N 6^S** RANGE **6^E W**

DISTANCE _____ MILES _____ of _____ MILES _____ of _____ MILES
DIRECTION **MOSS POINT** NEAREST TOWN

OTHER LANDMARK

WELL PURPOSE: Home, Irrigation, Municipal, Industrial, Fish Pond, etc.
lawn

PUMP DATA

PUMP TYPE (Circle One):
Submersible, Turbine, **Jet** Flowing Well, Other (Describe) _____

POWER TYPE (Circle One):
Electric Tractor, Diesel, Gasoline, Butane, Other (Describe) _____

Pump Capacity (GPM) **11** No. of Stages **1** Setting Depth _____ FT.

PUMP TEST

Well yielded _____ GPM with a drawdown of _____ ft. after _____ hours of pumping

WELL DATA

Well Depth 75'	Casing Diameter (In.) 2"	Casing Length (Ft.) 65'
Type of Casing PVC	Hole Depth 75'	Depth to Static Water Level 14'

TYPE OF COMPLETION: (Circle One or More):
Natural Development, Gravel Packed, Underreamed, Telescoped, Open Hole, Other

Top of Lap Pipe or Reduction in Casing _____ FEET

IF TELESCOPED OR MORE THAN ONE SCREEN: USE BACK PAGE

LOG DATA

TYPE OF LOG RUN (Circle One):
Electric, Gamma Ray, Density, Sonic, Neutron, **No Log Run**, Other (Describe) _____

Name of Organization Running Log _____


SCREEN DATA

Diameter - Inches 2"	Length - Feet 10'	Slot Size - Inches .008
Screen Type PVC	Depth to Bottom - Feet 75'	

GEOLOGIC DATA (Office Use Only)

Surface Elev.	Geologic Unit	Unit Thickness	Depth to Top
Subs. SWL	Date	Analysis	Aquifer Test

Driller's Remarks

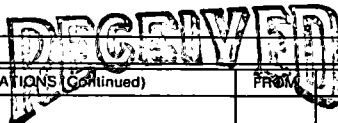

DESCRIPTION OF FORMATIONS ENCOUNTERED	FROM	TO	FORMATIONS (Continued)	FROM	TO
Top Soil	0	2			
Blue Clay	2	41			
White Coarse sand + Gravel	41	75			

NOV 15 1988

Department of Natural Resources
Bureau of Land & Water Resources

