

MISSISSIPPI DEPARTMENT OF NATURAL RESOURCES
Bureau of Land and Water Resources

P.O. Box 10631

Jackson, Mississippi 39209

WATER WELL DRILLERS LOG

COUNTY WELL LOCATED Jackson	
WELL NUMBER P2168	CODED
DATE WELL COMPLETED 6-20-88	

PERMIT NUMBER
NAME OF DRILLING FIRM Coastwater Well Serv.

NAME & MAILING ADDRESS OF LANDOWNER Dr Burrows			
4105 Hospital Rd			
Pascagoula MS 39567			
WELL LOCATION: SEC	TOWNSHIP	RANGE	
8	8 N	6	W
DISTANCE 1 1/2 Miles	DIRECTION -	NEAREST TOWN PASCAGOULA	
OTHER LANDMARK			
WELL PURPOSE: Home, Irrigation, Municipal, Industrial, Fish Pond, etc. law			

PUMP DATA		
PUMP TYPE (Circle One): Submersible , Turbine, Jet, Flowing Well, Other (Describe)		
POWER TYPE (Circle One): Electric , Tractor, Diesel, Gasoline, Butane, Other (Describe)		
Pump Capacity (GPM) 30	No. of Stages 9	Setting Depth - FT.
PUMP TEST		
Well yielded _____ GPM with a drawdown of _____ ft. after _____ hours of pumping		

WELL DATA		
Well Depth 225	Casing Diameter (In.) 4"	Casing Length (Ft.) 195'
Type of Casing PVC	Hole Depth 225	Depth to Static Water Level 40'
TYPE OF COMPLETION: (Circle One or More): Natural Development , Gravel Packed, Underreamed, Telescoped, Open Hole, Other (Describe)		
Top of Lap Pipe or Reduction in Casing		
FEET		
IF TELESCOPED OR MORE THAN ONE SCREEN: USE BACK PAGE		

LOG DATA	
TYPE OF LOG RUN (Circle One): No Log Run , Electric, Gamma Ray, Density, Sonic, Neutron, Other (Describe)	
Name of Organization Running Log	

SCREEN DATA		
Diameter - Inches 4"	Length - Feet 30'	Slot Size - Inches .008
Screen Type PVC	Depth to Bottom - Feet 225'	

GEOLOGIC DATA (Office Use Only)			
Surface Elev.	Geologic Unit	Unit Thickness	Depth to Top
Subs. SWL	Date	Analysis	Aquifer Test


Driller's Remarks	
RECEIVED	

DESCRIPTION OF FORMATIONS ENCOUNTERED	FROM	TO	FORMATIONS (Continued)	FROM	TO
Top soil	0	2	NOV 15 1988		
Blue Clay	2	62	Department of Natural Resources		
White Coarse sand	62	165	Bureau of Land & Water Resources		
Blue Clay w/ streaks of sand	165	180			
Gray Coarse sand	180	225			

IF MORE SPACE IS NEEDED, USE BACK

If well telescopes please sketch and show depths.

GROUND LEVEL

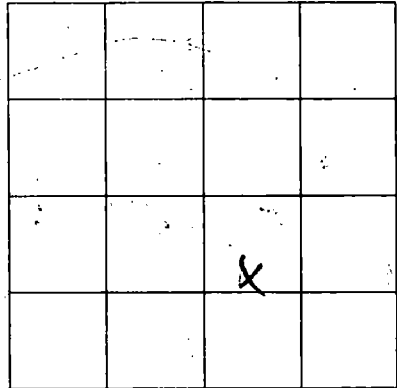

SECTION 8

Please indicate well location X.

ADDITIONAL INFORMATION

A series of horizontal lines for writing additional information, located to the right of the 'ADDITIONAL INFORMATION' header.

If more than one screen, show location of each on sketch.