

SOUTHERN WATER WELL SERVICE
 Post Office Box 85
 Purley, MS 39555
 Phone 588-2756
 2177

MISSISSIPPI DEPARTMENT OF NATURAL RESOURCES
 Bureau of Land and Water Resources
 Southport Mall
 P.O. Box 10631
 Jackson, Mississippi 39209
WATER WELL DRILLERS LOG

6-20-90 19 Southern Well Dr. firm name Jackson county well located

LANDOWNER: Mc Donnell
Stonestead Rd
Prater
 (mailing address)

description of formations encountered	from	to
<u>Sand</u>	<u>0</u>	<u>10</u>
<u>Clay</u>	<u>10</u>	<u>35</u>
<u>Sandy clay</u>	<u>35</u>	<u>45</u>
<u>Sand</u>	<u>45</u>	<u>65</u>

WELL LOCATION:
 sec. 7 T. 2 N. R. 6 E.
City of Prater
 (distance) (direction) (nearest town)

WELL PURPOSE: Drinking
 (home, irrigation, municipal, industrial)

- WELL COMPLETION DATA:
- (1) diameter (inches) 2"
 - (2) total depth (feet) 65'
 - (3) static water level (feet) 18' below above top of ground.
 - (4) casing PVC, 60'
 (material) (depth)
 - (size) If telescope see back.
 - (5) screen 5', 60'
 (length) (depth to top)
 - 2", PVC
 (size) (material)
 - (6) pump 1/2, 8
 (HP) (yield gpm)
 - AC
 (type power)
 - (7) electric log NO
 (yes or no)
 - N/A
 (organization running log)
 - (8) how well bottom plugged BWV

RECEIVED


AUG 29 1990

Department of Natural Resources
 Bureau of Land & Water Resources

DRILLERS REMARKS:

If well telescopes please sketch and show depths.

GROUND LEVEL

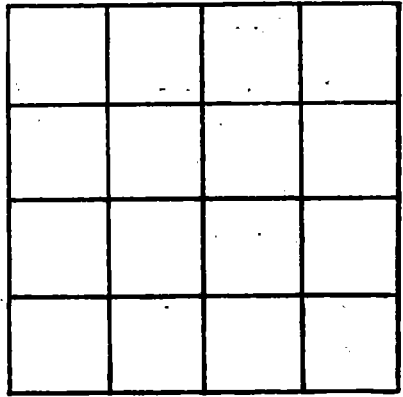

SECTION _____

Please indicate well location X.

ADDITIONAL INFORMATION

If more than one screen, show locations of each on sketch.