

MISSISSIPPI DEPARTMENT OF NATURAL RESOURCES

Bureau of Land and Water Resources

Southport Mall

P.O. Box 10631

Jackson, Mississippi 39209

SOUTHERN WATER WELL DRILLERS LOG

Post Office Box 185

Hurley, MS 39555

Phone 365-  
firm name

Jackson  
P 2178

Jackson  
county well located

6-15-90  
date well completed

LANDOWNER:

Don Wood  
Preston St  
Mossburn MS  
(mailing address)

description of formations encountered

from

to

Gravelly sand  
clay  
sand  
sand  
0 10  
10 35  
35 45  
50 75

WELL LOCATION:

sec. 16 T 7 N R 6 E  
City of Mossburn  
(distance) (direction) (nearest town)

WELL PURPOSE:

(home, irrigation, municipal, industrial)

WELL COMPLETION DATA:

- (1) diameter (inches) 2"
- (2) total depth (feet) 75'
- (3) static water level (feet) 8' (below above top of ground)
- (4) casing PVC, 70' (material) (depth)  
(size) if telescope see back.
- (5) screen 5' 70' (length) (depth to top)  
2" PVC (size) (material)
- (6) pump 1 (HP) 12 (yield gpm)  
AC (type power)
- (7) electric log (yes or no)

(organization running log)

(8) how well bottom plugged BWD

DRILLERS REMARKS:


RECEIVED

AUG 29 1990

Department of Natural Resources  
Bureau of Land & Water Resources

If well telescopes please sketch and show depths.

GROUND LEVEL

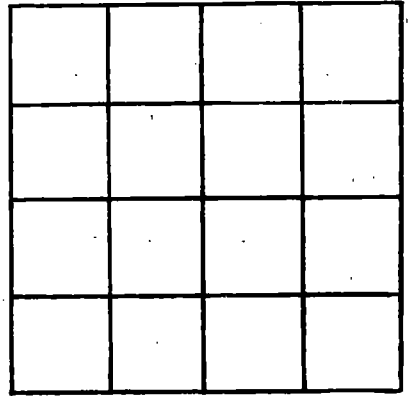

SECTION \_\_\_\_\_

Please indicate well location X.

ADDITIONAL INFORMATION

If more than one screen, show locations of each on sketch.