

MISSISSIPPI DEPARTMENT OF NATURAL RESOURCES

Bureau of Land and Water Resources

Southport Mall

P.O. Box 10631

Jackson, Mississippi 39209

SOUTHERN WATER WELL DRILLERS LOG

Post Office Box 185

Hurley, MS 39236

Phone 500-2444 firm name

Jackson county well located

Jackson
P 2179

6-7-90

date well completed

LANDOWNER:

Huff
Ruter Rd
Meridian Ms
(mailing address)

description of formations encountered

from

to

<u>sandy soil</u>	<u>0</u>	<u>15</u>
<u>clay</u>	<u>15</u>	<u>35</u>
<u>sandy clay</u>	<u>35</u>	<u>50</u>
<u>sand</u>	<u>50</u>	<u>65</u>

WELL LOCATION:

sec. 15 T. 7 N. R. 6 E.
S W
City of Meridian
(distance) miles (direction) of (nearest town)

WELL PURPOSE: irrigation
(home, irrigation, municipal, industrial)

WELL COMPLETION DATA:

- (1) diameter (inches) 2"
- (2) total depth (feet) 65'
- (3) static water level (feet) 5' below above top of ground.
- (4) casing PVC, 60'
(material), (depth)
(size) If telescope see back.
- (5) screen 5', 60'
(length), (depth to top)
2", PVC
(size), (material)
- (6) pump 1/2, 10
(HP), (yield gpm)
AC
(type power)
- (7) electric log NO
(yes or no)
N/A
(organization running log)
- (8) how well bottom plugged _____

RECEIVED


AUG 29 1990

Department of Natural Resources
Bureau of Land & Water Resources

DRILLERS REMARKS:

If well telescopes please sketch and show depths.

GROUND LEVEL

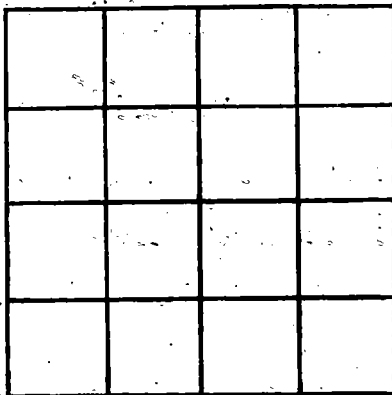

SECTION _____

Please indicate well location X.

ADDITIONAL INFORMATION

If more than one screen,
show locations of each on sketch.