

MISSISSIPPI DEPARTMENT OF ENVIRONMENTAL QUALITY
Bureau of Land and Water Resources

P. O. Box 10631
Jackson, MS 39289-0631
WATER WELL DRILLERS LOG

COUNTY WELL LOCATED <i>Jackson</i>	
WELL NUMBER <i>F484</i>	CODED
DATE WELL COMPLETED <i>9-2-92</i>	

PERMIT NUMBER
NAME OF DRILLING FIRM <i>Coast Water Well Dr Inc</i>

NAME & MAILING ADDRESS OF LANDOWNER <i>Kenny Smith Mc Cluskey</i>			
WELL LOCATION: SEC <u>3</u> TOWNSHIP <u>7^N 6^W</u> RANGE <u>6^W</u>			
DISTANCE <u>3</u> Miles	DIRECTION <u>N</u>	NEAREST TOWN <u>Stattin</u>	
OTHER LANDMARK			
WELL PURPOSE: <input checked="" type="checkbox"/> Home, <input type="checkbox"/> Irrigation, <input type="checkbox"/> Municipal, <input type="checkbox"/> Industrial, <input type="checkbox"/> Fish Pond, etc.			

PUMP DATA		
PUMP TYPE (Circle One): <input checked="" type="radio"/> Submersible, <input type="radio"/> Turbine, <input type="radio"/> Jet, <input type="radio"/> Flowing Well, Other (Describe) _____		
POWER TYPE (Circle One): <input checked="" type="radio"/> Electric, <input type="radio"/> Tractor, <input type="radio"/> Diesel, <input type="radio"/> Gasoline, <input type="radio"/> Butane, Other (Describe) _____ H/P <u>1</u>		
Pump Capacity (GPM) <u>20</u>	No. of Stages	Setting Depth <u> </u> FT.
PUMP TEST		
Well yielded _____ GPM with a drawdown of _____ ft. after _____ hours of pumping		

WELL DATA		
Well Depth <u>690</u>	Casing Diameter (In.) <u>2 1/4 4"</u>	Casing Length (Ft.) <u>200'-4 1/2"</u> <u>490'-2"</u>
Type of Casing <u>PVC</u>	Hole Depth <u>690'</u>	Depth to Static Water Level <u>751</u>
TYPE OF COMPLETION: (Circle One or More): <input checked="" type="checkbox"/> Gravel Packed, <input type="checkbox"/> Underreamed, <input type="checkbox"/> Telescoped, <input checked="" type="checkbox"/> Natural Development, <input type="checkbox"/> Open Hole, <input type="checkbox"/> Other		
Top of Lap Pipe or Reduction in Casing <u> </u> FEET		
IF TELESCOPED OR MORE THAN ONE SCREEN: USE BACK PAGE		

LOG DATA	
TYPE OF LOG RUN (Circle One): <input checked="" type="radio"/> No Log Run, <input type="radio"/> Electric, <input type="radio"/> Gamma Ray, <input type="radio"/> Density, <input type="radio"/> Sonic, <input type="radio"/> Neutron, Other (Describe) _____	
Name of Organization Running Log <u> </u>	

SCREEN DATA		
Diameter - Inches <u>2 1/4"</u>	Length - Feet <u>20'</u>	Slot Size - Inches <u>00</u>
Screen Type <u>PVC</u>	Depth to Bottom - Feet <u>690'</u>	

GEOLOGIC DATA (Office Use Only)			
Surficial Soil	Geologic Unit	Unit Thickness	Depth to Top
Subs. SWL	Date	Analysis	Aquifer Test


Driller's Remarks

DESCRIPTION OF FORMATIONS ENCOUNTERED	FROM	TO
<i>Top soil</i>	<i>0</i>	<i>2</i>
<i>Yellow clay</i>	<i>2</i>	<i>18</i>
<i>Grey sand</i>	<i>18</i>	<i>35</i>
<i>15 of clay</i>	<i>35</i>	<i>55</i>
<i>Med. sand</i>	<i>55</i>	<i>90</i>
<i>Blue clay 5 of sand</i>	<i>90</i>	<i>145</i>
<i>Med. sand</i>	<i>145</i>	<i>160</i>
<i>Med. sand 5 of Blue clay</i>	<i>160</i>	<i>310</i>
<i>Grey sand</i>	<i>310</i>	<i>344</i>
<i>Blue clay 5 of sand</i>	<i>344</i>	<i>640</i>
<i>Med. to coarse sand</i>	<i>640</i>	<i>690</i>

FORMATIONS (Continued)	FROM	TO
RECEIVED		
OCT 07 1992		
Dept. of Environmental Quality Bureau of Land & Water Resources		
IF MORE SPACE IS NEEDED, USE BACK		

If well telescopes please sketch and show depths.

GROUND LEVEL

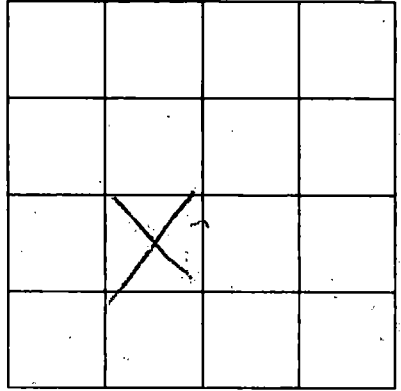

SECTION _____

Please indicate well location X.

ADDITIONAL INFORMATION

PROCESSED

WHO intended to use
a. which well to use

If more than one screen,
show location of each on sketch.