

**MISSISSIPPI DEPARTMENT OF ENVIRONMENTAL QUALITY**  
Bureau of Land and Water Resources

P. O. Box 10631  
Jackson, MS 39289-0631  
**WATER WELL DRILLERS LOG**

COUNTY WELL LOCATED <i>Jackson</i>	
WELL NUMBER <i>FW 2187</i>	CODED
DATE WELL COMPLETED <i>5-28-93</i>	

PERMIT NUMBER
NAME OF DRILLING FIRM <i>Coast Water Well Driller Inc.</i>

NAME & MAILING ADDRESS OF LANDOWNER <i>Leon Meade</i>			
<i>1005 Pine Cone Drive</i>			
<i>Gautier, Ms. 39553</i>			
WELL LOCATION:	SEC	TOWNSHIP	RANGE
	<i>7</i>	<i>2 N 6 E</i>	<i>6</i>
DISTANCE	DIRECTION	NEAREST TOWN	
<i>4</i> Miles	<i>N</i>	of <i>GAUTIER</i>	
OTHER LANDMARK			
WELL PURPOSE: Home, Irrigation, Municipal, Industrial, Fish Pond, etc. <i>LAWN CARE</i>			

<b>PUMP DATA</b>		
PUMP TYPE (Circle One): Submersible, Turbine, <u><i>JWT</i></u> Flowing Well, Other (Describe) _____		
POWER TYPE (Circle One): <u><i>Electric</i></u> Tractor, Diesel, Gasoline, Butane, Other (Describe) _____ <i>H/P 1</i>		
Pump Capacity (GPM) <i>16</i>	No. of Stages <i>2</i>	Setting Depth _____ <b>FT.</b>
PUMP TEST		
Well yielded _____ GPM with a drawdown of _____ ft. after _____ hours of pumping		


<b>WELL DATA</b>		
Well Depth <i>90'</i>	Casing Diameter (In.) <i>2"</i>	Casing Length (Ft.) <i>80'</i>
Type of Casing <i>PVC</i>	Hole Depth <i>90'</i>	Depth to Static Water Level <i>22'</i>
TYPE OF COMPLETION: (Circle One or More): Gravel Packed, Underreamed, Telescoped, <u><i>Natural Development</i></u> , Open Hole, Other (Describe) _____		
Top of Lap Pipe or Reduction in Casing		
<b>FEET</b>	IF TELESCOPED OR MORE THAN ONE SCREEN: USE BACK PAGE	

<b>LOG DATA</b>	
TYPE OF LOG RUN (Circle One): Electric, Gamma Ray, Density, Sonic, Neutron, Other (Describe) _____ <u><i>No Log Run</i></u>	
Name of Organization Running Log	

<b>SCREEN DATA</b>			
Diameter - Inches <i>2"</i>	Length - Feet <i>10'</i>	Slot Size - Inches <i>.008</i>	
Screen Type <i>PVC</i>		Depth to Bottom - Feet <i>90'</i>	


<b>GEOLOGIC DATA (Office Use Only)</b>			
Surface Elev.	Geologic Unit	Unit Thickness	Depth to Top
Subs. SWL	Date	Analysis	Aquifer Test
Driller's Remarks			

DESCRIPTION OF FORMATIONS ENCOUNTERED	FROM	TO	FORMATIONS (Continued)	FROM	TO
<i>top soil</i>	<i>0</i>	<i>1</i>			
<i>Red med. sand</i>	<i>1</i>	<i>15</i>			
<i>white clay</i>	<i>15</i>	<i>52</i>			
<i>Red coarse sand</i>	<i>52</i>	<i>90</i>			

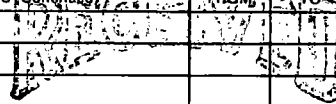  
**JUL 20 1993**  
 Dept. of Environmental Quality  
 Office of Land & Water Resources

If well telescopes please sketch and show depths.

GROUND LEVEL

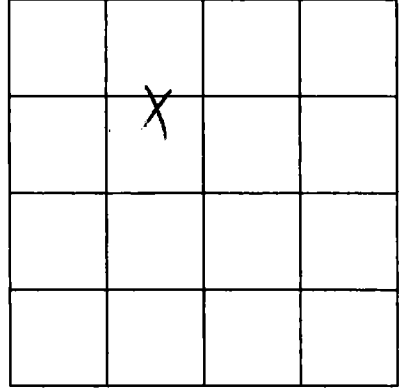

SECTION 7

Please indicate well location X.

ADDITIONAL INFORMATION

If more than one screen,  
show location of each on sketch.