

Jackson
F

6-8-66

MISSISSIPPI BOARD OF WATER COMMISSIONERS

P 2191

WATER WELL DRILLERS LOG

Date: 6-8, 1966, Driller: Letter Well Works County Jackson
(When well drilled) (Name) (Where well is located)

(1) Owner of Land: Ford Vance
(Name)
Hattiesburg, Miss.
(Address)

(2) Location: N 1/4, SE 1/4, Sec. 32 T. 7 S. R. 6 W
1 miles N, of Hattiesburg
(distance) (direction) (Nearest Town)

(3) Topography: flat
(Hilly) (Flat) (Level)

(4) Purpose of Well: domestic
(Domestic Irrigation
Municipal, Industrial, Other)

Description & Color of Materials Sand, Clay, Red Clay, Shell, etc.	Thick- ness Feet	Depth Feet
Clay	15	15
Sand	8	23
Clay - Sand streaks	35	108
Sand	30	138
Clay	60	198
Sand	85	283
		None

Information upon completion of well:

(1) Diameter 2x4 inches.

(2) Total Depth 283 ^{well} feet.

(3) Water Level 11 feet below top of ground. 273 ^{TOP 63'-4"}

(4) Cased to all, Size 2"

(5) Screen: Size 2", Length 10'

(6) Were any formations sealed against pollution?
 yes, no.

If YES depth of formation _____


Why _____

Drillers Remarks: _____

Yield in gpm: 75

Size pump: 1 hp subm

Type power: elec

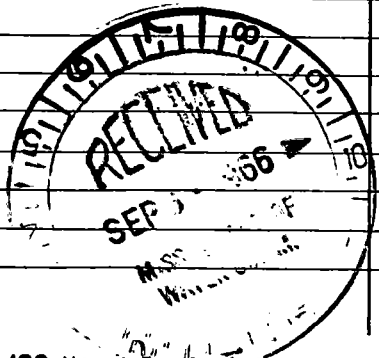

1911

Received of Mr. J. H. ...

the sum of ...

John ...

...

11

...

...

...

...