

MISSISSIPPI DEPARTMENT OF NATURAL RESOURCES

Bureau of Land and Water Resources

Southport Mall

P.O. Box 10631

Jackson, Mississippi 39209

WATER WELL DRILLERS LOG

JACKSON
P-2192
8-4-81

Coast Water Well Service, Jackson

8-4-81 date well completed 19 firm name county well located

LANDOWNER: *Low Eral Church*
633 Hwy 90 E.
Gautier, Miss.
(mailing address) *39513*

description of formations encountered	from	to
<i>Top soil</i>	<i>0</i>	<i>3'</i>
<i>R. Clay</i>	<i>3</i>	<i>35'</i>
<i>O sand</i>	<i>35'</i>	<i>90'</i>
<i>B. Clay</i>	<i>90'</i>	<i>115'</i>
<i>O. sand</i>	<i>115'</i>	<i>170'</i>
<i>B. Clay</i>	<i>170'</i>	<i>215'</i>
<i>M.C. Sand</i>	<i>215'</i>	<i>280'</i>

WELL LOCATION:
sec *2* T *8* S R *6*
IN miles (distance) of *GAUTIER* (direction) of (nearest town)

WELL PURPOSE: *Home*
(home, irrigation, municipal, industrial)

WELL COMPLETION DATA:


- (1) diameter (Inches) *2"*
- (2) total depth (feet) *280'*
- (3) static water level (feet) *20'* ^{below} ~~above~~ top of ground.
- (4) casing *PVC* *270'*
(material) (depth)
2" (size) if telescope see back.
- (5) screen *10'* *270'*
(length) (depth to top)
2" (size) *PVC* (material)
- (6) pump *1 hp.* *8 1/2*
(HP) (yield gpm)
Elec. (type power)
- (7) electric log *No.*
(yes or no)
(organization running log)
- (8) how well bottom plugged
Backwash valve



DRILLERS REMARKS:

If well telescopes please sketch and show depths.

GROUND LEVEL

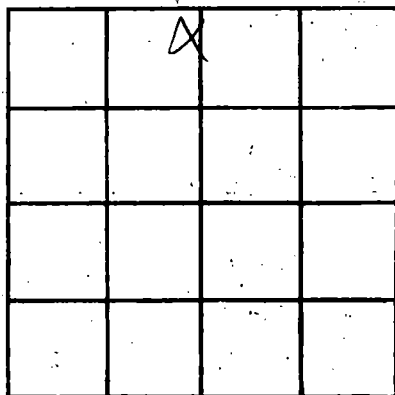

SECTION 2

Please indicate well location X.

ADDITIONAL INFORMATION

If more than one screen,
show locations of each on sketch.