

MISSISSIPPI DEPARTMENT OF ENVIRONMENTAL QUALITY

Office of Land and Water Resources

P. O. Box 10631
Jackson, MS 39289-0631

WATER WELL DRILLERS LOG

COUNTY WELL LOCATED Jackson	
WELL NUMBER P 2195	CODED
DATE WELL COMPLETED 7-1-94	

PERMIT NUMBER
NAME OF DRILLING FIRM Coast Water Well Service

NAME & MAILING ADDRESS OF LANDOWNER M & M Bait			
Hwy 90			
Pascagoula, Ms.			
WELL LOCATION	SEC	TOWNSHIP	RANGE
	14	7	6
DISTANCE	DIRECTION	NEAREST MARKER	
1/4 Miles	West	PASCAGOULA RIVER	
OTHER LANDMARK N of Hwy 90			
WELL PURPOSE Home, Irrigation, Municipal, Industrial, Fish Pond, etc. TRY TO RAISE LIVE BAIT (SALT)			

PUMP DATA		
PUMP TYPE (Circle One): Submersible, Turbine, Jet, Flowing Well, Other (Describe) _____		
POWER TYPE (Circle One): Electric, Tractor, Diesel, Gasoline, Butane, Other (Describe) _____ H/P		
Pump Capacity (GPM)	No. of Stages	Setting Depth _____ FT.
PUMP TEST		
Well yielded _____ GPM with		a drawdown of _____ ft.
after _____ hours of pumping		

WELL DATA		
Well Depth 85'	Casing Diameter (In) 2"	Casing Length (Ft.) 70'
Type of Casing PVC	Hole Depth 85'	Depth to Static Water Level 2'

LOG DATA	
TYPE OF LOG RUN (Circle One): Electric, Gamma Ray, Density, Sonic, Neutron, Other (Describe) _____	
Name of Organization Running Log _____	

TYPE OF COMPLETION: (Circle One or More):
 Gravel Packed Underreamed Telescoped
 Natural Development Open Hole Other
 (Describe) _____

WELL GROUTED TO A DEPTH OF **70** FEET
 Type Grout (circle one): Cement, **Bentonite** or Mix

GEOLOGIC DATA (Office Use Only)			
Surface Elev.	Geologic Unit	Unit Thickness	Depth to Top
Subs. SWL	Date	Analysis	Aquifer Test

SCREEN DATA		
Diameter - Inches 2"	Length - Feet 15'	Slot Size - Inches .008
Screen Type PVC	Depth to Bottom - Feet 85'	


Driller's Remarks
Top of Lap Pipe or Reduction in Casing _____ FEET
IF TELESCOPED OR MORE THAN ONE SCREEN: USE BACK PAGE

DESCRIPTION OF FORMATIONS ENCOUNTERED	FROM	TO
Silt Dirt	0	2
Black Mud	2	40
Coarse Sand	40	85

FORMATIONS (Continued)	FROM	TO
RECEIVED		
AUG 17 1994		
Dept. of Environmental Quality Office of Land & Water Resources		
IF MORE SPACE IS NEEDED USE BACK		

If well telescopes please sketch and show depths.

GROUND LEVEL

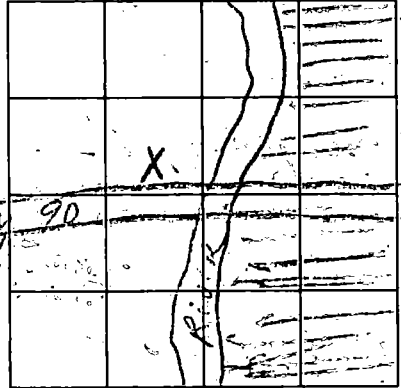

SECTION

14

Please indicate well location X.

ADDITIONAL INFORMATION

A series of horizontal lines provided for additional information.

RECEIVED

APR 1 1964

U.S. GEOLOGICAL SURVEY
WASHINGTON, D.C. 20540

If more than one screen,
show location of each on sketch.