
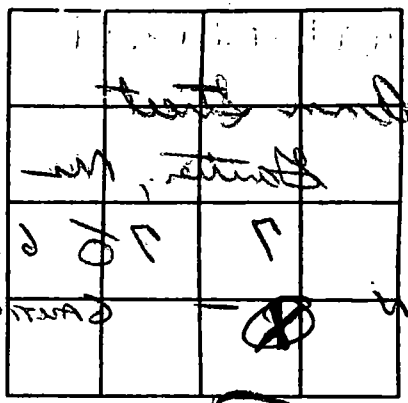


If well telescopes please sketch and show depths.

Handwritten notes and scribbles at the top of the page.

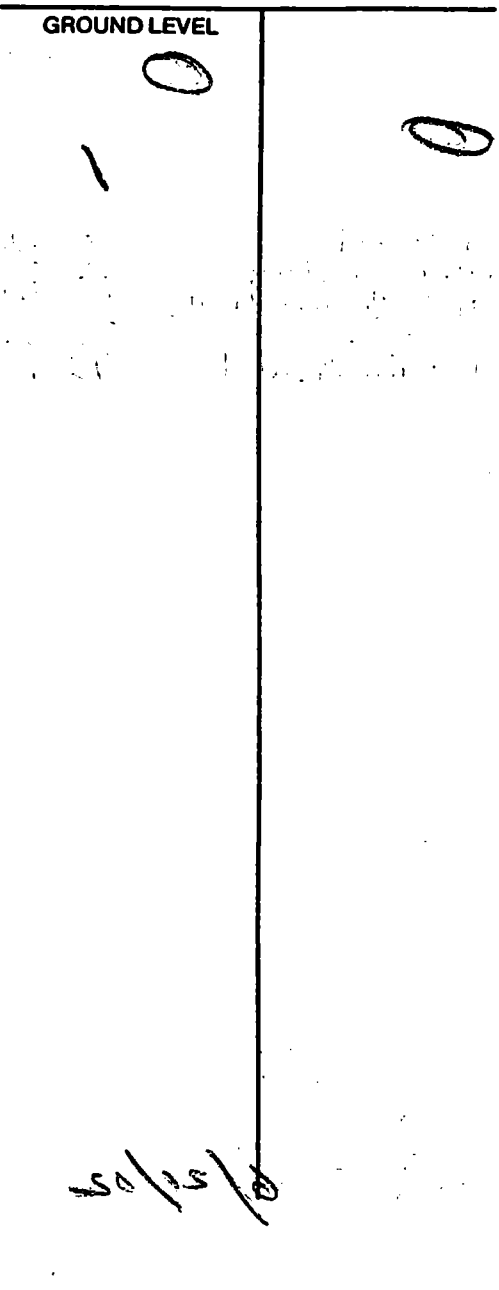

SECTION 114

Please indicate well location X.

Pump Capacity (GPM) 12	No. of Stages 1	Setting Depth 10	FT.
PUMP TEST			
Well yielded _____ GPM with a drawdown of _____ ft. after _____ hours of pumping			

LOG DATA

TYPE OF LOG RUN (Circle One): No Log Run
 Electric; Gamma Ray, Density, Sonic, Neutron, Other (Describe) _____

Name of Organization Running Log _____

GEOLOGIC DATA (Office Use Only)

Surface Elev.	Geologic Unit	Unit Thickness	Depth to Top
Subs. SWL	Date	Analysis	Aquifer Test
Driller's Remarks <i>SP4 114/114</i>			

Handwritten notes at the bottom left of the page.

If more than one screen, show location of each on sketch.