

MISSISSIPPI DEPARTMENT OF NATURAL RESOURCES

Bureau of Land and Water Resources

Southport Mall

P.O. Box 10631

Jackson, Mississippi 39209

WATER WELL DRILLERS LOG

JACKSON  
 P

10-4-85 19  
 date well completed

Coast Water Well Sew. Jackson  
 firm name county well located

LANDOWNER: Angela's Aunt Hospital  
Hospital Road  
Pascagoula Miss.  
 (mailing address) 39567

| description of formations encountered | from | to   |
|---------------------------------------|------|------|
| Top soil                              | 0    | 5'   |
| Blue Clay                             | 5'   | 30'  |
| White Coarse sand                     | 30'  | 42'  |
| Blue Clay                             | 42'  | 65'  |
| White Coarse sand and gravel          | 65'  | 126' |

WELL LOCATION:

sec. 7 T. 8 N. R. 6 E  
 S W  
1N miles (distance) of Pascagoula (nearest town)

WELL PURPOSE: Irrigation  
 (home, irrigation, municipal, industrial)

WELL COMPLETION DATA:

- (1) diameter (inches) 6"
- (2) total depth (feet) 126'
- (3) static water level (feet) 21' below above top of ground.
- (4) casing PVC 106'  
 (material) (depth)  
6" if telescope see back.  
 (size)
- (5) screen 20' 106'  
 (length) (depth to top)  
6" PVC  
 (size) (material)
- (6) pump 3 hp. 1/2" 1000  
 (HP) (yield gpm)  
Electric  
 (type power)
- (7) electric log No  
 (yes or no)  
\_\_\_\_\_  
 (organization running log)
- (8) how well bottom plugged  
Back Wash Valve

RECEIVED


NOV 26 1985

Department of Natural Resources  
 Bureau of Land & Water Resources

DRILLERS REMARKS:

If well telescopes please sketch and show depths.

GROUND LEVEL

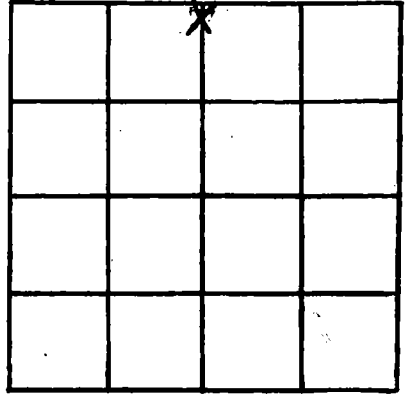

SECTION 7

Please indicate well location X.

ADDITIONAL INFORMATION

If more than one screen, show locations of each on sketch.