

JACKSON  
P-  
9/2/76

MISSISSIPPI  
BOARD OF WATER COMMISSIONERS  
416 North State Street  
Jackson, Mississippi 39201

WATER WELL DRILLERS LOG

9/2 1976 Coast Water Well Inc Jackson  
date well completed firm name county well located

LANDOWNER: Compton Engineers

5622 Orchard Rd.

Pascagoula, Ms.  
(mailing address)

WELL LOCATION:  
sec. 12 T. 8 R. 6  
in Pascagoula  
miles (distance) (direction) of (nearest town)

WELL PURPOSE: Test - City  
(home, irrigation, municipal, industrial)

WELL COMPLETION DATA:

- (1) diameter (inches) 6"
- (2) total depth (feet) 182'
- (3) static water level (feet) 25 below above top of ground.
- (4) casing PVC, 122'  
(material) (depth)  
6" If telescope see back.  
(size)
- (5) screen 60', 122'  
(length) (depth to top)  
4", all stainless  
(size) (material)
- (6) pump (HP) (yield gpm)  
(type power)
- (7) electric log No  
(yes or no)

(organization running log)

(8) how well bottom plugged Blw Valve

DRILLERS REMARKS:

description of formations encountered	from	to
<u>top soil</u>	<u>0</u>	<u>17</u>
<u>blue clay</u>	<u>17</u>	<u>64</u>
<u>coarse sand</u>	<u>64</u>	<u>182</u>


Can't find sec 12 on Road map in Pascagoula

RECEIVED  
MAR - 9 1977

MISS. BD. OF WATER COMMISSIONERS

If well telescopes please sketch and show depths.

GROUND LEVEL

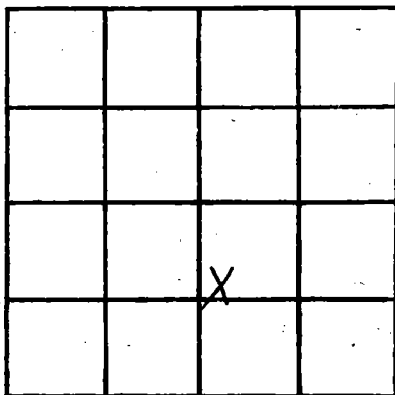

SECTION 12

Please indicate well location X.

ADDITIONAL INFORMATION

If more than one screen, show locations of each on sketch.