

**JACKSON**  
**DQ 73**  
**11-15-60**

E 1064111

**CODED**

**WATER WELL DRILLERS LOG**

1369

File in presence

Date: 11-15, 1960, Driller: C. J. Switzer Well Co. County Jackson  
 (Name)

(1) Owner of Land: J. L. Harper  
 (Name)  
East Lawn Avenue  
Passaquilla, Miss  
 (Address)

(2) Location: 1/4, 1/4, Sec. 29 T 8 R 5  
3  
 \_\_\_\_\_ miles \_\_\_\_\_ of \_\_\_\_\_  
 (distance) (direction) (Nearest Town)

(3) Topography: ✓  
 (Hilly) (Flat) (Level)

(4) Purpose of Well: Domestic  
 (Domestic Irrigation  
 Municipal, Industrial, Other)

Description & Color of Materials Sand, Clay, Red Clay, Shell, etc.	Thick-ness Feet	Depth Feet
Sand	15	15
Clay	64	79
Sand	8	87
Clay	20	107
Clay + sand streaks	23	130
Sand	78	208
Clay	75	283
Clay + sand streaks	22	305
Clay	43	348
Sand streak	23	371
Clay	44	415
Clay + sand streak	22	437
Clay	21	458
Sand streak	22	480
Clay + shell	22	502
Clay	44	546
Sand	5	551
Sand streaks	17	568
Clay + shell	23	591
Shell + sand streak	22	613
Shell	13	626
Fine sand	9	635
Sand	32	667

Information upon completion of well:

(1) Diameter 4x6 inches.

(2) Total Depth 665 feet.


(3) Water Level 28 feet below top of ground.

(4) Cased to 665, Size 4x6.

(5) Screen: Size 4x6, Length 35 ft.

(6) Were any formations sealed against pollution?  
 \_\_\_\_\_ Yes, \_\_\_\_\_ no.

If YES depth of formation 10 feet  
 Why Health Dept. Requirement  
 Drillers Remarks: \_\_\_\_\_

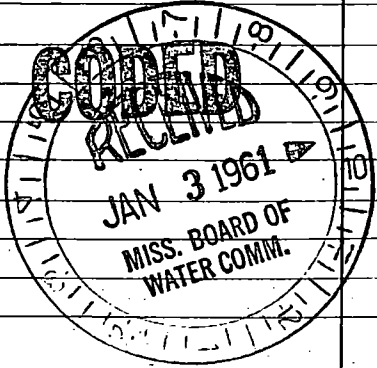

(Use Back Side)

Well No.

