

# JACKSON MISSISSIPPI BOARD OF WATER COMMISSIONERS

~~159~~

Q 74  
8-23-60

## WATER WELL DRILLERS LOG

Colville Water

Date: 8/23, 1960, Driller: Supply Co County: Jackson  
(Name)

(1) Owner of Land: RF Krebs  
(Name)  
RFD Pascagoula  
(Address)

(2) Location: SE 1/4 NE 1/4, Section 7  
1/4 miles East, of Pascagoula  
(distance) (direction) (Nearest Town)

(3) Topography: \_\_\_\_\_  
(Hilly) (Flat) (Level)


(4) Purpose of Well: Emergency Stand By  
(Domestic Irrigation  
Municipal, Industrial, Other)

Description & Color of Materials Sand, Clay, Red Clay, Shell, etc.		Thick- ness Feet	Depth Feet
depth	Form	depth	FORM
0	Slush	10	Soft Mud
21	Soft Mud	52	Sand
67	Sand + gravel	106	
Total Depth			
106'			

### Information upon completion of well:

- (1) Diameter 3 inches.
- (2) Total Depth 106 feet.
- (3) Water Level 17.5 feet below top of ground.
- (4) Cased to \_\_\_\_\_, Size \_\_\_\_\_.
- (5) Screen: Size 3", Length 10'.
- (6) Were any formations sealed against pollution?  
\_\_\_\_\_ yes, \_\_\_\_\_ no.

If YES depth of formation \_\_\_\_\_  
Why \_\_\_\_\_  
Drillers Remarks: \_\_\_\_\_

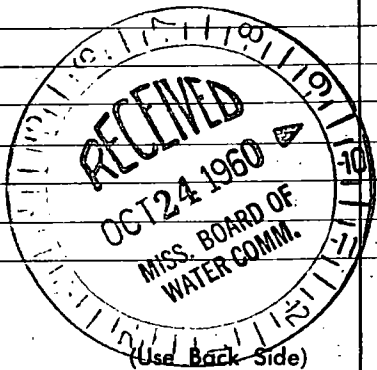

Well No. \_\_\_\_\_

