

Q 99  
 9-22-60

WATER WELL DRILLERS LOG

Date: 9/22, 1960, Driller: Colville Water Supply Co County Jackson  
 3 Q (Name)

(1) Owner of Land: FA Russell  
 (Name)  
RFD Pasagoula Miss  
 (Address)  
 (2) Location: NE 1/4 NE 1/4, Sec. 18  
2 miles E of Pasagoula  
 (distance) (direction) (Nearest Town)  
 (3) Topography: \_\_\_\_\_  
 (Hilly) (Flat) (Level)   
 (4) Purpose of Well: \_\_\_\_\_  
 (Domestic Irrigation) (Municipal, Industrial, Other)


Description & Color of Materials Sand, Clay, Red Clay, Shell, etc.	Thick-ness Feet	Depth Feet
0' Slush	15	Mud
25 SAND	74	Clay
95 SAND	132	Clay
140 SAND	145	Clay
147 SAND	231	Clay
305 SAND	336	

Information upon completion of well:

(1) Diameter 7 inches.  
 (2) Total Depth 336 feet.  
 (3) Water Level 44 feet below top of ground.  
 (4) Cased to \_\_\_\_\_, Size \_\_\_\_\_  
 (5) Screen: Size 2", Length 20  
 (6) Were any formations sealed against pollution?  
 \_\_\_\_\_ yes, \_\_\_\_\_ no.

Total Depth 336

If YES depth of formation \_\_\_\_\_  
 Why \_\_\_\_\_  
 Drillers Remarks: \_\_\_\_\_

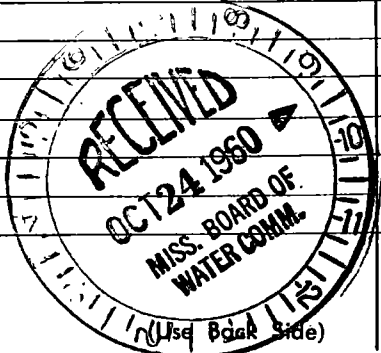

Well No. 111

