

Q 125
 6-3-61

WATER WELL DRILLERS LOG


Date: 6/3, 1961, Driller: Colville Water Supply Co. County JACKSON
 4 R (Name)

	Description & Color of Materials Sand, Clay, Red Clay, Shell, etc.	Thick- ness Feet	Depth Feet
(1) Owner of Land: <u>Garland Cox</u> (Name) <u>Bayou Casotte</u> (Address)			
(2) Location: <u>SW 1/4, SW 1/4, Sec. 8 T22R5W</u> <u>2</u> miles <u>East</u> of <u>Pascagoula</u> (distance) (direction) (Nearest Town)			
(3) Topography: <input checked="" type="checkbox"/> (Level) (Hilly) (Flat) (Level)	Depth Form <u>0</u> SAND	Depth Form <u>15</u>	FORM <u>CLAY</u>
(4) Purpose of Well: <input checked="" type="checkbox"/> Domestic Irrigation Municipal, Industrial, Other	<u>84</u> CLAY	<u>90</u>	<u>SAND</u>
	<u>111</u> IR		

Information upon completion of well:

- (1) Diameter 1 1/4 inches.
 (2) Total Depth 111 feet.
 (3) Water Level 12 feet below top of ground.
 (4) Cased to _____, Size _____
 (5) Screen: Size 1 1/4, Length 5'
 (6) Were any formations sealed against pollution?
 _____ yes, _____ no.

If YES depth of formation _____
 Why _____
 Drillers Remarks: _____

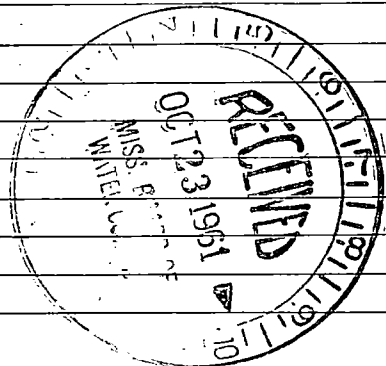

(Use Back Side)

Well No. 56

