

WATER WELL DRILLERS LOG

Well No. 2

 Date: 9-13-, 1963, Driller: Layne-Central Co. County Jackson

29

(Name)

(1) Owner of Land: Standard Oil Co.
 (Name)
Pascagoula, Miss.
 (Address)

(2) Location: 1/4, NW 1/4, Sec. 16 T8 R5
 (distance) miles of
 (direction) (Nearest Town)

(3) Topography:
 (Hilly) (Flat) (Level)

(4) Purpose of Well: Industrial
 (Domestic Irrigation
 Municipal, Industrial, Other)

Description & Color of Materials Sand, Clay, Red Clay, Shell, etc.	Thick- ness Feet	Depth Feet
soil	2	2
sandy x clay	4	6
sand	8	14
blue clay	26	40
sandy clay (loose)	30	70
blue clay	49	119
fine loosesand & clay balls	9	128
packed sand	84	212
clay	67	279
clay, sandy stks. (loose)	14	293
packed sand, stks. clay	16	309
clay	5	314
soft sand & clay	12	326
packed sand	16	342
sand & clay stks	15	357
packed sand	14	371
clay	21	392

Information upon completion of well:

(1) Diameter 18 inches.

(2) Total Depth 387 feet.

(3) Water Level 56 feet below top of ground.

(4) Cased to 275', Size 18"


(5) Screen: Size 12", Length 75'

(6) Were any formations sealed against pollution?
 yes, no.

If YES, depth of formation 275'

Why required

Drillers Remarks:

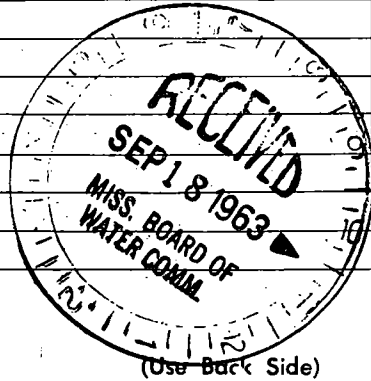

(Use Back Side)

Well No.

1108

ysio a ybuaa

huan

ysio ouid

(saco) yoi ybuaa

ysio ouid

ysio ouid

si ad yoi

ysio ouid

ysio

ysio ouid

ysio ouid

ysio

ysio ouid

ysio ouid

100
101
102
120