

JACKSON MISSISSIPPI BOARD OF WATER COMMISSIONERS

Q 143

WATER WELL DRILLERS LOG

~~8-29-61~~

8-29-61

Date: 8-29, 19 61, Driller: Sutter Well Wks. Co. Jackson

49

(Name)

	Description & Color of Materials Sand, Clay, Red Clay, Shell, etc.	Thick- ness Feet	Depth Feet
(1) Owner of Land: <u>Jackson County</u> (Name) <u>Board of Supervisors</u> (Address)	Clay	110	110
(2) Location: <u>SE 1/4, NE 1/4, Sec. 8 T85R54</u> <u>1</u> miles <u>E</u> of <u>Pascagoula</u> (distance) (direction) (Nearest town)	Sand & gravel Clay Sand Clay - sand streaks Sand	94 41 30 506 23	204 245 275 781 804
(3) Topography: <u>level</u> (Hilly) (Flat) (Level)			
(4) Purpose of Well: <u>farm</u> (Domestic, Irrigation, Municipal, Industrial, Other)			


Information upon completion of well:

- (1) Diameter 4 inches.
- (2) Total Depth 814 feet.
- (3) Water level 1 feet above below top of ground.
- (4) Cased to cell, Size 4"
- (5) Screen: Size 4", Length 20
- (6) Were any formations sealed against pollution?
 yes, no.

If YES depth of formation _____

Why _____

Drillers Remarks: _____

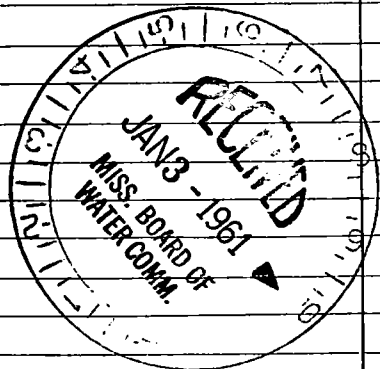

(Use Back Side)

Well No.

