

4 P


Jackson
Q 145
3-67

MISSISSIPPI
BOARD OF WATER COMMISSIONERS
416 North State Street
Jackson, Mississippi 39201

WATER WELL DRILLERS LOG

March 1967 date well completed
Switzer Well Co. firm name
Jackson county well located


LANDOWNER	description of formations encountered	from	to
H. K. Oster Co.			
Bayou Canotte Industrial Area	clay	0	17
Pascagoula, Miss.	mixed sand & clay	17	34
(mailing address)	clay, sand & shells	34	57
	sand	57	63
WELL LOCATION:	clay	63	116
sec. 20 T. 8 S. R. 5 W.	sand	116	124
2 miles E of PASCAGOULA	sand & logs	124	146
(distance) (direction) (nearest town)	sand	146	211
	mixed	211	233
WELL PURPOSE: Industrial	clay	233	294
(home, irrigation, municipal, industrial)	mixed	294	300
	sand	300	360
WELL COMPLETION DATA:			
(1) diameter (inches) 12 x 8			
(2) total depth (feet) 360			
(3) static water level (feet) 78 below top of ground.			
(4) casing gal. steel, 309' 2" (material) (depth)			
12 x 8 If telescope see back. (size)			
(5) screen 50' 8" (length), 309' 2" (depth to top)			
12 ga. stainless steel (size) (material) on pipe			
(6) pump 40 (HP) 400 (yield gpm)			
electric (type power)			
(7) electric log Yes (yes or no)			
(organization running log)			
(8) how well bottom plugged back pressure valve			
DRILLERS REMARKS:			

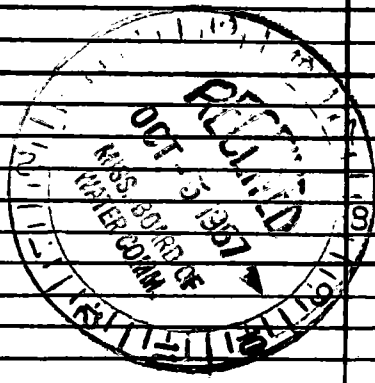

If well telescopes please sketch and show depths.

GROUND LEVEL

SWSE

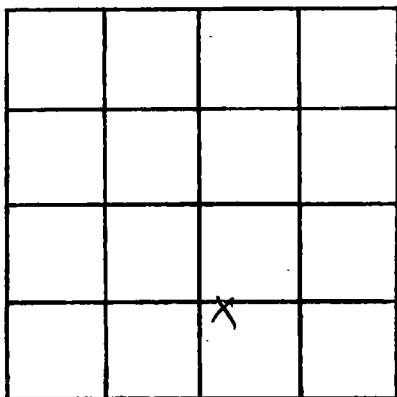

SECTION 20

Please indicate well location X.

ADDITIONAL INFORMATION

If more than one screen, show locations of each on sketch.