

JACKSON

Q 147

11-1-62

WATER WELL DRILLERS LOG


Date: Nov 1, 1962, Driller: George Colville County Jackson
 49 (Name)

	Description & Color of Materials Sand, Clay, Red Clay, Shell, etc.	Thick- ness Feet	Depth Feet
(1) Owner of Land: <u>City Saver's Supply Co</u> (Name) <u>Kreole Moss</u> (Address)	0-21 sand		
(2) Location: <u>SE 1/4, SE 1/4, Sec. 21 T75R5E4</u> <u>1 1/4 miles east</u> , of <u>Kreole</u> (distance) (direction) (Nearest Town)	21-90 clay 90-95 sand 95-105 clay 105-116 sand TD		
(3) Topography: <u>Flat</u> (Hilly) (Flat) (Level)			
(4) Purpose of Well: <u>Domestic</u> (Domestic Irrigation Municipal, Industrial, Other)			

Information upon completion of well:

- (1) Diameter 1 1/4 inches.
- (2) Total Depth 116 feet.
- (3) Water Level 11' feet below top of ground.
- (4) Cased to _____, Size _____
- (5) Screen: Size 1 1/4, Length 5'
- (6) Were any formations sealed against pollution?
 _____ yes, no.

If YES depth of formation _____
 Why _____
 Drillers Remarks: _____

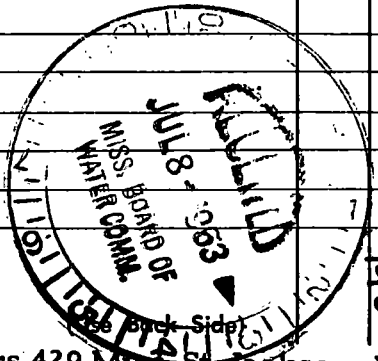

Well No. 147

