

49
Jackson
DD 149
6-63

MISSISSIPPI
 BOARD OF WATER COMMISSIONERS
 416 North State Street
 Jackson, Mississippi 39201

WATER WELL DRILLERS LOG

June 8 1963 Colville Water Supply Co. Inc. Jackson
 date well completed firm name county well located

LANDOWNER: Alaisy Fresh
Cooperation
Pascagoula Miss.
 (mailing address)


WELL LOCATION: 5
 sec. 6 T. 8 N. R. 4 E
1/2 miles west of Pascagoula
 (distance) (direction) (nearest town)

description of formations encountered	from to	
<u>bluish</u>	<u>0</u>	<u>18</u>
<u>Sand</u>	<u>18</u>	<u>178</u>
<u>Clay</u>	<u>178</u>	<u>231</u>
<u>Sand</u>	<u>231</u>	<u>333</u>

WELL PURPOSE: Domestic
 (home, irrigation, municipal, industrial)

- WELL COMPLETION DATA:
- (1) diameter (inches) 4"
 - (2) total depth (feet) 333
 - (3) static water level (feet) 634 ^{below} _{above} top of ground.
 - (4) casing Steel, 168
 (material) (depth)
4"
 (size) If telescope see back.
 - (5) screen 10, 323
 (length) (depth to top)
2", Drum
 (size) (material)
 - (6) pump 2, 30
 (HP) (yield gpm)
elec
 (type power)
 - (7) electric log no
 (yes or no)
 (organization running log)
 - (8) how well bottom plugged B.P. Vehr


DRILLERS REMARKS:

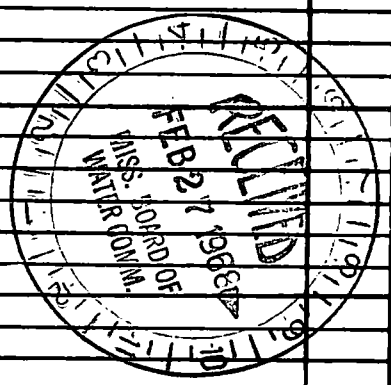

If well telescopes please sketch and show depths.

GROUND LEVEL

NE NE

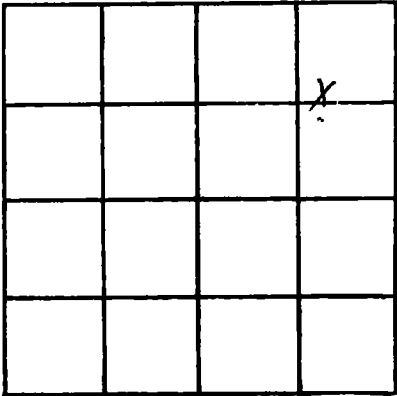

SECTION 6

Please indicate well location X.

ADDITIONAL INFORMATION

If more than one screen, show locations of each on sketch.