

44

Jackson
DD150
5-63

MISSISSIPPI
BOARD OF WATER COMMISSIONERS
416 North State Street
Jackson, Mississippi 39201

WATER WELL DRILLERS LOG

May 17 1963 Colville Water Supply Co. Inc. Jackson
date well completed firm name county well located

LANDOWNER: Magrelia Welding

description of formations encountered

from to

Supply (Phil Ware)

Slush 0 21

Pascagoula Miss
(mailing address)

Sand 21 184

Clay 184 230

Sand 230 325

WELL LOCATION:

sec. 6 T. 8 N. R. 12 E.
1/2 miles east of Pascagoula
(distance) (direction) (nearest town)

WELL PURPOSE: Industrial
(home, irrigation, municipal, industrial)

WELL COMPLETION DATA:

(1) diameter (inches) 2"
(2) total depth (feet) 325
(3) static water level (feet) 60' 10" below above top of ground.

(4) casing (material), (depth),
(size) if telescope see back.

(5) screen 5, 320
(length) (depth to top)
2, BRASS
(size) (material)


(6) pump 1, 6
(HP) (yield gpm)
elec
(type power)

(7) electric log no
(yes or no)

(organization running log)

(8) how well bottom plugged B.P. Valoy


DRILLERS REMARKS:

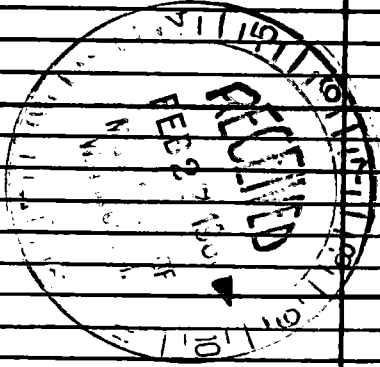

If well telescopes please sketch and show depths.

GROUND LEVEL

NE NE

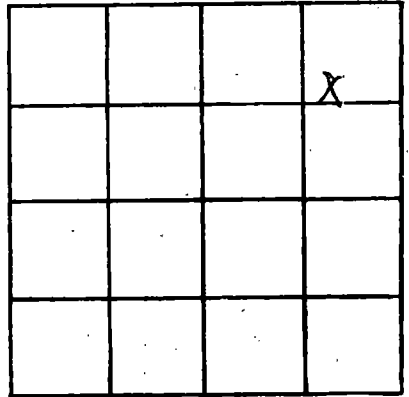

SECTION 6

Please indicate well location X.

ADDITIONAL INFORMATION

If more than one screen, show locations of each on sketch.