

JACKSON MISSISSIPPI BOARD OF WATER COMMISSIONERS

Q 151

2-15-65

WATER WELL DRILLERS LOG

Date: 2-15, 19 65, Driller: Sutter Well Works County Jackson
 49 (Name)

(1) Owner of Land: Fishmeal Corp.
 (Name)

Mass Point Miss.
 (Address)

(2) Location: SW 1/4, S W 1/4, Sec. 17 T25R5W

1 1/2 miles IN Mass Point
 (distance) (direction) (Nearest Town)

(3) Topography: flat
 (Hilly) (flat) (Level)

(4) Purpose of Well: Industrial
 (Domestic Irrigation
 Municipal, Industrial, Other)

Description & Color of Materials Sand, Clay, Red Clay, Shell, etc.	Thick- ness Feet	Depth Feet
<u>Clay</u>	<u>18</u>	<u>18</u>
<u>Sand</u>	<u>12</u>	<u>30</u>
<u>Clay</u>	<u>45</u>	<u>75</u>
<u>Sand</u>	<u>30</u>	<u>105</u>
<u>Rock</u>	<u>2</u>	<u>107</u>
<u>Soft clay</u>	<u>33</u>	<u>140</u>
<u>Sand</u>	<u>92</u>	<u>232</u>


Information upon completion of well:

- (1) Diameter 12 inches.
- (2) Total Depth 232 feet.
- (3) Water Level 30 feet below top of ground.
- (4) Cased to all, Size 12"
- (5) Screen: Size 9 5/8", Length 50'
- (6) Were any formations sealed against pollution?
 yes, no.

If YES depth of formation _____

Why _____

Drillers Remarks: _____

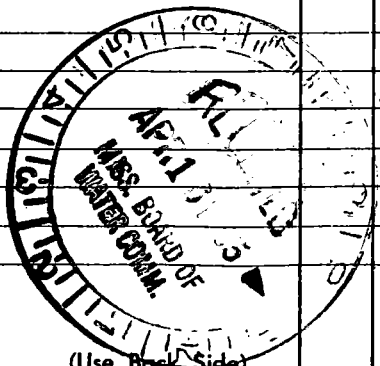

Well No. _____

(Use Back Side)

