

Jackson 152 WATER WELL DRILLERS LOG

Date: APR. 14, 1966, Driller: J.C. STORK (Colville) County Jackson


(1) Owner of Land: ARVIS V. CUMBEST (Name)
56 DEL NORDE CIRCLE, PASADENA (Address)
(2) Location: 1/4, 1/4, Sec. 18 T8R51E (Address)
0 miles E of Pas. (distance) (direction) (Nearest Town)
(3) Topography: LEVEL (Hilly) (Flat) (Level)
(4) Purpose of Well: IRR. (Domestic Irrigation, Municipal, Industrial, Other)

Table with 3 columns: Description & Color of Materials (Sand, Clay, Red Clay, Shell, etc.), Thickness Feet, Depth Feet. Contains handwritten entries for Clay (60) and Sand (24).

Information upon completion of well:

(1) Diameter: 2 inches.
(2) Total Depth: 84 feet.
(3) Water Level: -15'-6" feet below top of ground.
(4) Cased to: 79, Size: 2 in.
(5) Screen: Size: 2.008, Length: 5 ft.
(6) Were any formations sealed against pollution? yes, [check] no.

If YES depth of formation:
Why:
Drillers Remarks:

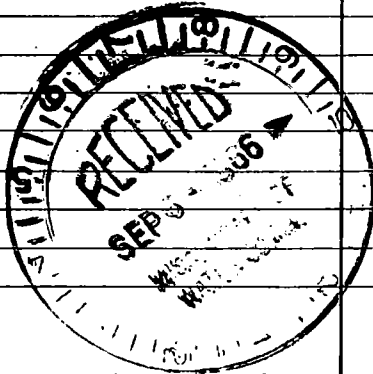

Well No.

(Use Back Side)

