

**JACKSON MISSISSIPPI BOARD OF WATER COMMISSIONERS**

Q 154

11-10-60

**WATER WELL DRILLERS LOG**

~~301~~

Date: 11/10, 1960, Driller: Water Supply Co County JACKSON  
 49 (Name)

(1) Owner of Land: SL. Harris  
 (Name)

R3. Box 70 Pascagoula Miss  
 (Address)

(2) Location: SW 1/4, NW 1/4, Sec. 18 T85R5W  
1 1/4 miles SE of Pascagoula  
 (distance) (direction) (Nearest Town)

(3) Topography: \_\_\_\_\_  
 (Hilly) (Flat) (Level)

(4) Purpose of Well: \_\_\_\_\_  
 Domestic Irrigation  
 Municipal, Industrial, Other

Description & Color of Materials Sand, Clay, Red Clay, Shell, etc.		Thick- ness Feet	Depth Feet
0	SLUSH	15	CLAY
21	CLAY	42	STREAKS
64	SAND	84	
89			

**Information upon completion of well:**

(1) Diameter 1 1/4 inches.

(2) Total Depth 89 feet.

(3) Water Level - 10 feet below top of ground.

(4) Cased to \_\_\_\_\_, Size \_\_\_\_\_


(5) Screen: Size 1 1/4, Length 5

(6) Were any formations sealed against pollution?  
 \_\_\_\_\_ yes, \_\_\_\_\_ no.

If YES depth of formation \_\_\_\_\_

Why \_\_\_\_\_

Drillers Remarks: \_\_\_\_\_

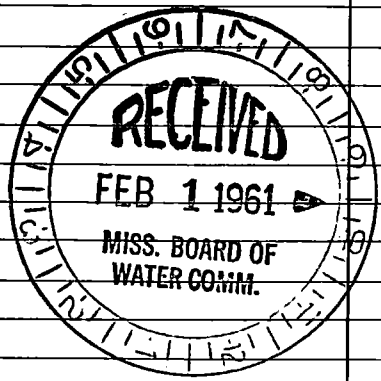

Well No. 21

(Use Back Side)

