

JACKSON

Q 155

12-18-60

WATER WELL DRILLERS LOG

Colville

Date: 12/18, 1960, Driller: Water Supply Co County JACKSON



4-9

(1) Owner of Land: W W Dyle
(Name)
RFD Pascagoula
(Address)

(2) Location SE 1/4 SW 1/4, Sec. 8 T8R5E1W
2 1/2 miles S East, of Pascagoula
(distance) (direction) (Nearest Town)

(3) Topography: (Level) (Flat) (Hilly)

(4) Purpose of Well: Domestic Irrigation
 Municipal, Industrial, Other

Description & Color of Materials Sand, Clay, Red Clay, Shell, etc.		Thick- ness Feet	Depth Feet
0	Slush	11	CLAY
42	STREAKS	63	CLAY
73	STREAKS	84	CLAY
102	SAND	105	CLAY
123	SAND	126	

Information upon completion of well:

(1) Diameter 2 inches.

(2) Total Depth 126 feet.

(3) Water Level 13 feet below top of ground.

(4) Cased to _____, Size _____


(5) Screen: Size 2, Length 6'

(6) Were any formations sealed against pollution?
_____ yes, _____ no.

If YES depth of formation _____

Why _____

Drillers Remarks: _____

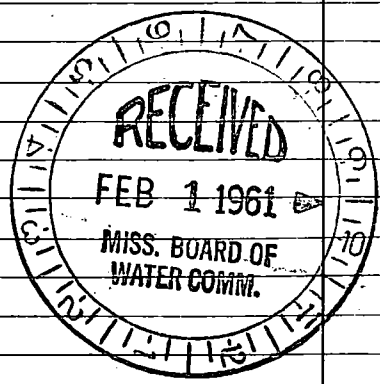

(Use Back Side)

Well No. 49

