

Q 157

2-7-61

WATER WELL DRILLERS LOG

~~Q 157~~

Colville

Date: 2/7, 1961, Driller: Water Supply Co. County JACKSON
 4 R (Name)

(1) Owner of Land: M. SNELSON
 (Name)
 Orange Grove Miss
 (Address)

(2) Location: NW 1/4 NW 1/4, Sec 23 T5R5W
 5 miles East of Pascagoula
 (distance) (direction) (Nearest Town)

(3) Topography: (Hilly) (Flat) (Level)


(4) Purpose of Well: Domestic Irrigation
 Municipal, Industrial, Other

Description & Color of Materials Sand, Clay, Red Clay, Shell, etc.	Thick- ness Feet	Depth Feet
0 yellow clay	12	Sand
28 ID		

Information upon completion of well:

- (1) Diameter 1 1/4 inches.
- (2) Total Depth 68 feet.
- (3) Water Level 12 feet below top of ground.
- (4) Cased to _____, Size _____.
- (5) Screen: Size 1 1/4, Length 5'
- (6) Were any formations sealed against pollution?
 _____ yes, _____ no.

If YES depth of formation _____
 Why _____
 Drillers Remarks: _____

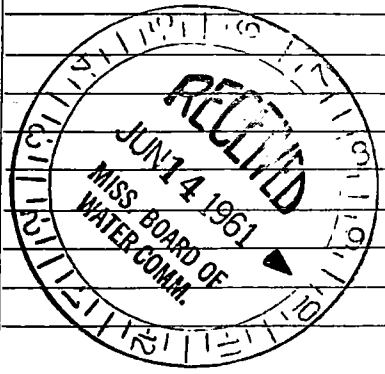

(Use Back Side)

Well No. 290

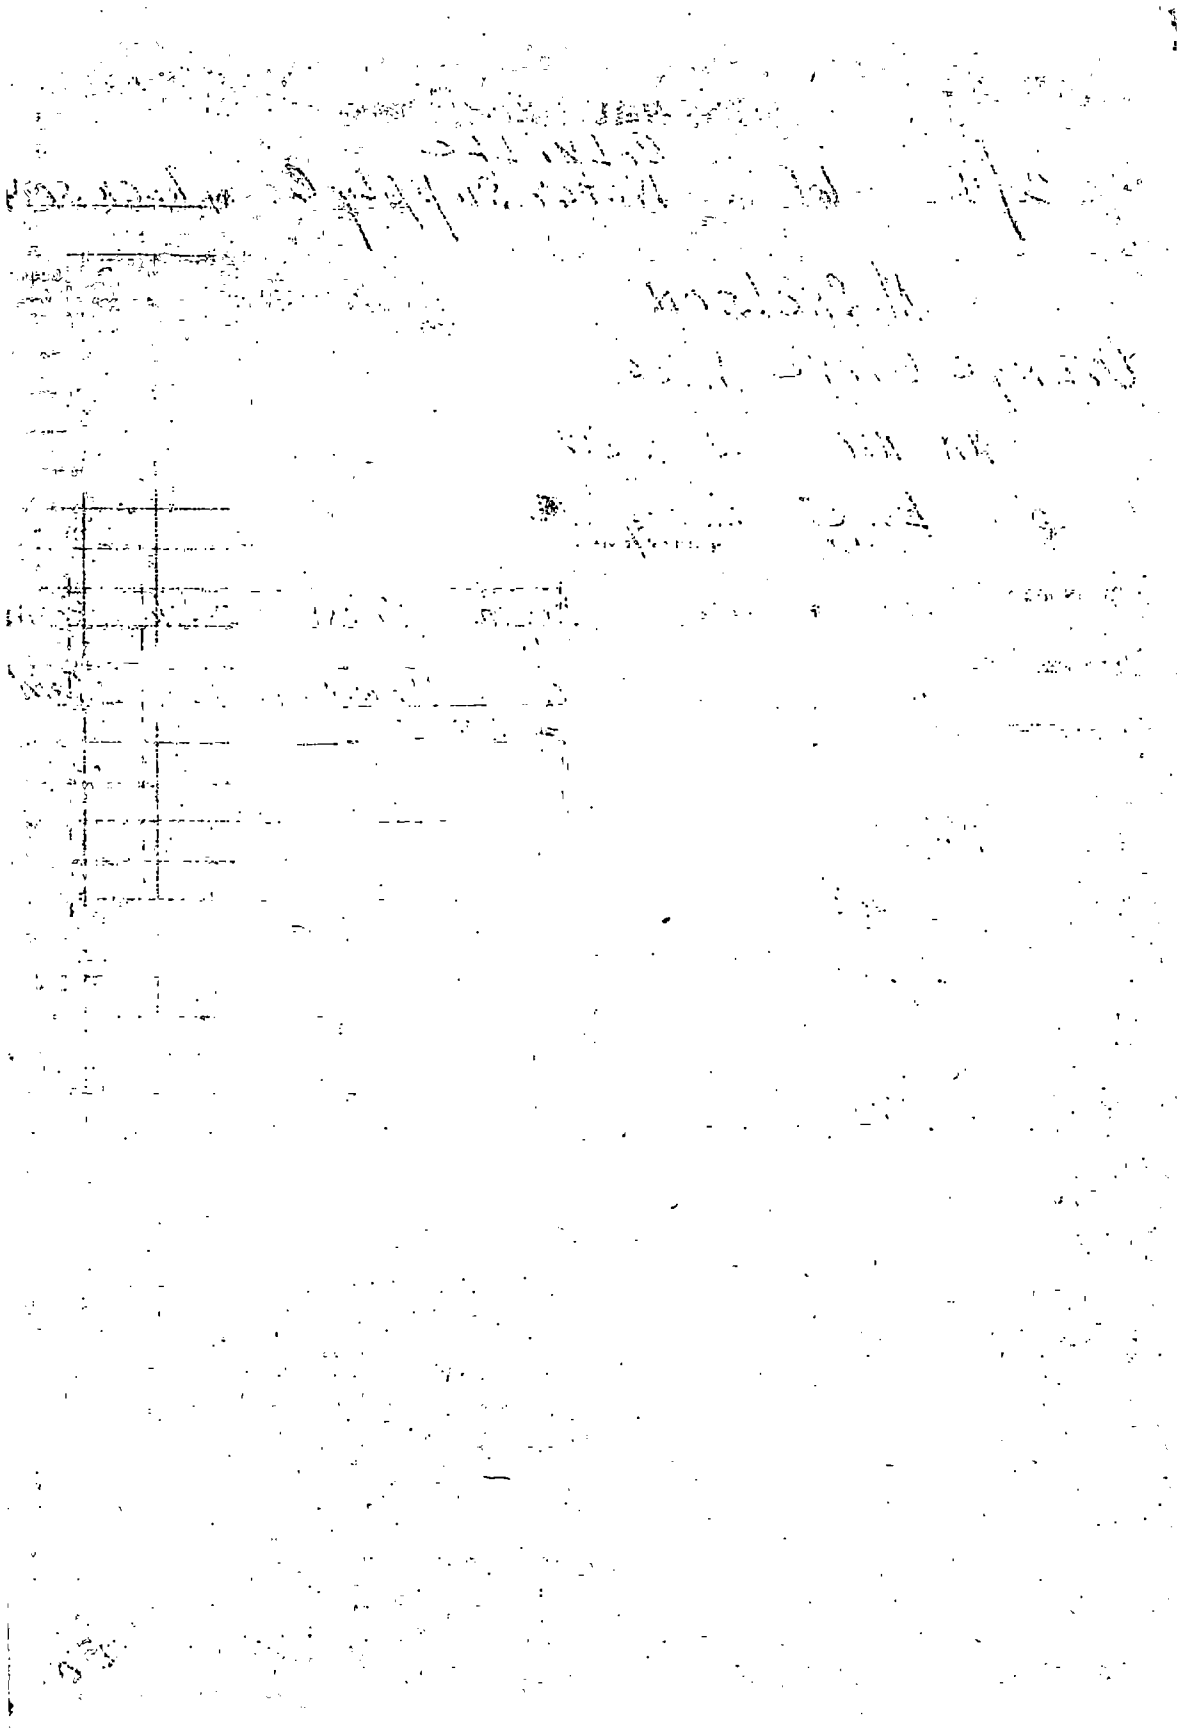


TABLE
NUMBER