

5-25-66 WATER WELL DRILLERS LOG

Date: May 25, 1966, Driller: George Colville County Jackson
 49 (Name)


(1) Owner of Land:	Description & Color of Materials Sand, Clay, Red Clay, Shell, etc.	Thick- ness Feet	Depth Feet
<u>Thio Kol Chem Corp.</u> (Name) <u>Escatawpa, Miss.</u> (Address)	<u>Yellow Clay</u>	<u>53</u>	<u>55</u>
	<u>band</u>	<u>11</u>	<u>66</u>
	<u>CLAY</u>	<u>6</u>	<u>72</u>
(2) Location: <u>NW 1/4, NW 1/4, Sec. 20 T. 75 S. W.</u>	<u>SAND</u>	<u>33</u>	<u>105</u>
<u>2</u> miles <u>N</u> of <u>MOSS POINT</u> (distance) (direction) (Nearest Town)	<u>CLAY</u>	<u>36</u>	<u>151</u>
	<u>SAND</u>	<u>89</u>	<u>240</u>
(3) Topography: <u>Level</u> (Hilly) (Flat) (Level)			
(4) Purpose of Well: <u>INDUSTRIAL</u> (Domestic Irrigation Municipal, Industrial, Other)			

Information upon completion of well:

- (1) Diameter 12 inches.
- (2) Total Depth 240 feet.
- (3) Water Level 31-6 feet below top of ground. 160-12 in.
- (4) Cased to 200-9 in. Size 12-9
- (5) Screen: Size 9 in. 90, Length 40 ft.
- (6) Were any formations sealed against pollution?
 yes, no.

If YES depth of formation 160 ft.
 Why Required by contract

Drillers Remarks:

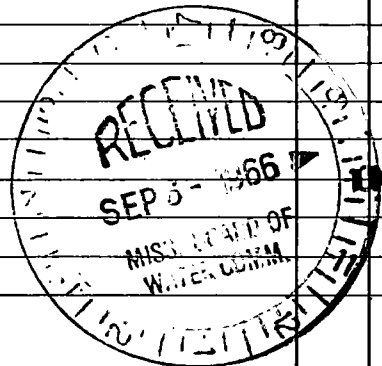

(Use Back Side)

Well No.

1918

1918

