

JACKSON MISSISSIPPI BOARD OF WATER COMMISSIONERS

Q 160

8-23-65

WATER WELL DRILLERS LOG

Date: 8-23, 1965, Driller: Sutter Well Works County Jackson
 4Q (Name)

(1) Owner of Land: Thinkal Corp.
 (Name)
Mass Point, Miss.
 (Address)

(2) Location: 1/4, SW 1/4, Sec. 17 T7 R5
SW
 miles 1/4 IN, of Mass Point
 (distance) (direction) (Nearest Town)

(3) Topography: flat
 (Hilly) (Flat) (Level)

(4) Purpose of Well: Industrial
 (Domestic Irrigation
 Municipal, Industrial, Other)


Description & Color of Materials Sand, Clay, Red Clay, Shell, etc.	Thick- ness Feet	Depth Feet
<u>Clay</u>	<u>32</u>	<u>32</u>
<u>Sand & Clay</u>	<u>31</u>	<u>63</u>
<u>Sand</u>	<u>47</u>	<u>110</u>
<u>Clay</u>	<u>39</u>	<u>149</u>
<u>sand</u>	<u>42</u>	<u>191</u>
<u>Clay</u>	<u>6</u>	<u>197</u>
<u>sand</u>	<u>39</u>	<u>236</u>

Information upon completion of well:

- (1) Diameter 12 inches.
- (2) Total Depth 236 feet.
- (3) Water Level 33 feet below top of ground.
- (4) Cased to all, Size 12"
- (5) Screen: Size 9 5/8", Length 50'
- (6) Were any formations sealed against pollution?
 yes, no.

If YES depth of formation entire
 Why _____

Drillers Remarks: _____

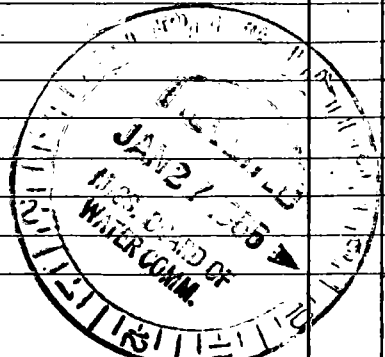

(Use Back Side)

Well No.

