

Q 173

Q 311

WATER WELL DRILLERS LOG

3-8-61

Date: 3/8, 1961, Driller: Colville Water Supply Co, County: JACKSON

(Name)

	Description & Color of Materials Sand, Clay, Red Clay, Shell, etc.	Thick- ness Feet	Depth Feet
(1) Owner of Land: <u>O Yates</u> <small>(Name)</small> <u>Orange Grove Miss</u> <small>(Address)</small>			
(2) Location: <u>NW 1/4 NW 1/4, Sec. 23 T25R5W</u> <u>5</u> miles <u>East</u> , of <u>Pascagoula</u> <small>(distance) (direction) (Nearest Town)</small>			
(3) Topography: <small>(Hilly) (Flat) <input checked="" type="checkbox"/> (Level)</small>			
(4) Purpose of Well: <small><input checked="" type="checkbox"/> Domestic Irrigation <input type="checkbox"/> Municipal, Industrial, Other</small>			

Depth Form depth form

0 clay 10 sand

140 clay 148 sand

242 2 10

Information upon completion of well:

(1) Diameter 1 1/4 inches.

(2) Total Depth 242 feet.

(3) Water Level 15 feet below top of ground.

(4) Cased to _____, Size _____.

(5) Screen: Size 1 1/4, Length 10'

(6) Were any formations sealed against pollution?
_____ yes, _____ no.


Water level

15'

If YES depth of formation _____

Why _____

Drillers Remarks: _____

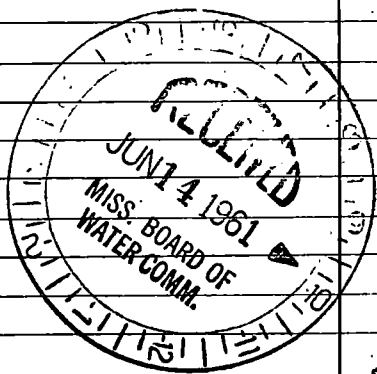

(Use Back Side)

Well No. 8

