

JACKSON MISSISSIPPI BOARD OF WATER COMMISSIONERS

10565 files

Q 181
6-11-65

WATER WELL DRILLERS LOG

Date: June 11, 1965, Driller: Carlson Well Supply County Jackson

(Name)

(1) Owner of Land: Jackson County Board of Supervisors, Jackson County, Mississippi

(2) Location: Bayou Casotte Well #2 (Address)
1/4, 1/4, Sec. 30 T8 R5W
_____ miles _____ of _____
(distance) (direction) (Nearest Town)

(3) Topography: Flat
(Hilly) (Flat) (Level)

(4) Purpose of Well: Municipal
(Domestic Irrigation, Municipal, Industrial, Other)

Information upon completion of well:

(1) Diameter 10 inches.

(2) Total Depth 682 feet.

(3) Water Level 43 feet below top of ground.

(4) Cased to 632 feet, Size 10 inches

(5) Screen: Size 6 inches length 45 feet

(6) Were any formations sealed against pollution?


XX yes, _____ no.

If YES depth of formation Casing

Why cemented entire length

Drillers Remarks: _____

Description & Color of Materials Sand, Clay, Red Clay, Shell, etc.	Thick-ness Feet	Depth Feet
Top soil	15'	15'
Sand & Blue Shale	15'	30'
Sand	10'	40'
Sand & Blue Shale	5'	45'
Logs	5'	50'
Sandy Shale	10'	60'
Sand	10'	70'
Sand & Shale Mixed	30'	100'
Sand	50'	150'
Coarse Sand	65'	215'
Hard Blue Shale	255'	470'
Hard Sandrock	5'	475'
Hard Blue Shale	15'	490'
Hard Shale-Gray	133'	623'
Sandy Shale	10'	633'
Water Bearing Sand	45'	678'

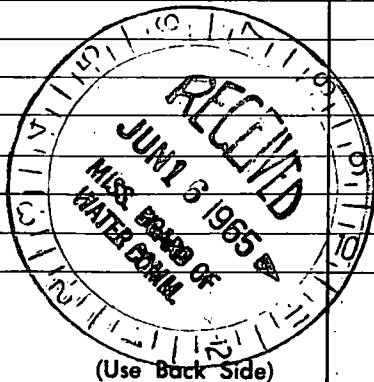

Well No. _____

