

Q 182

WATER WELL DRILLERS LOG

COLVILLE

4-28-61

Date: 4/28, 1961, Driller: Water Supply Co County JACKSON

4 R

(Name)

(1) Owner of Land OF Bass
(Name)
Helena Miss
(Address)

Description & Color of Materials
Sand, Clay, Red Clay, Shell, etc.

Thick-
ness
Feet

Depth
Feet

(2) Location: SW 1/4, NE 1/4, Sec. 2 T7RSW
8 miles NE of Moss Point
(distance) (direction) (Nearest Town)

Depth FORM depth FORM

(3) Topography: (Hilly) (Flat) (Level)

0 CLAY 42 SAND
52

(4) Purpose of Well: Domestic Irrigation
Municipal, Industrial, Other

Information upon completion of well:

(1) Diameter 1 1/4 inches.

ID 52

(2) Total Depth 52 feet.

W Level 14'

(3) Water Level 14' feet below top of ground.

(4) Cased to _____, Size _____


(5) Screen: Size 1 1/4, Length 5'

(6) Were any formations sealed against pollution?
_____ yes, _____ no.

If YES depth of formation _____

Why _____

Drillers Remarks: _____

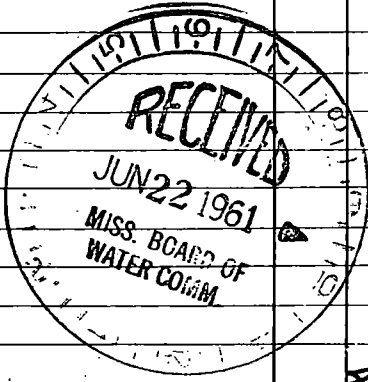

Well No. 4 R

(Use Back Side)

1934
D. H. ...

...

...

