

JACKSON MISSISSIPPI BOARD OF WATER COMMISSIONERS

Q 183

5-10-61


WATER WELL DRILLERS LOG

COLVILLE

Q 300

Date: 5/10, 1961, Driller: WATLEY Supply Co County: JACKSON
 4 R (Name)

	Description & Color of Materials Sand, Clay, Red Clay, Shell, etc.	Thick- ness Feet	Depth Feet
(1) Owner of Land: <u>CLAYENCE BROWN</u> (Name)			
<u>PECAN MISS</u> (Address)			
(2) Location: <u>NE 1/4, NE 1/4, Sec. 13 T7R5, W</u> <u>10</u> miles <u>East</u> , of <u>Pascagoula</u> (distance) (direction) (Nearest Town)			
(3) Topography: _____ (Hilly) (Flat) (Level) <input checked="" type="checkbox"/>	<u>Depth FORM</u>	<u>depth</u>	<u>FORM</u>
(4) Purpose of Well: <input checked="" type="checkbox"/> Domestic Irrigation Municipal, Industrial, Other	<u>0 clay 7</u>	<u>Blue Clay</u>	
	<u>26 clay 63</u>	<u>Sand</u>	
	<u>74 IR</u>		
Information upon completion of well:	<u>W Level 10'</u>		
(1) Diameter <u>1 1/4</u> inches.			
(2) Total Depth <u>74</u> feet.			
(3) Water Level <u>10'</u> feet below top of ground.			
(4) Cased to _____, Size _____			
(5) Screen: Size <u>1 1/4</u> , Length <u>5'</u>			
(6) Were any formations sealed against pollution? _____ yes, _____ no. <input checked="" type="checkbox"/>			
If YES depth of formation _____			
Why _____			
Drillers Remarks: _____			

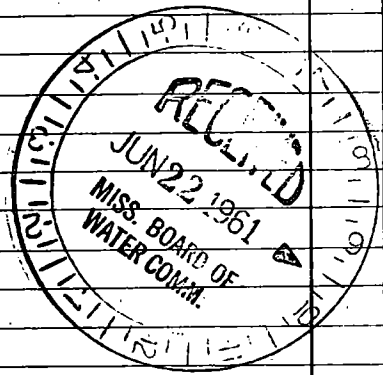

(Use Back Side)

Well No. 48

